


WELL PLUGGING RECORD

Give All Information Completely
Make Required Affidavit
Mud or Beliver Report to:
Conservation Division
State Corporation Commission
211 No. Broadway
Wichita, Kansas

Stafford

County, Sec. 3 Twp. 22 Rge. 13 (E) W (W)

Location as "NE/CNW%SW%" or footage from lines. NE SE NW
Lease Owner Petroleum, Inc.
Lease Name Gates "B" Well No. 1
Office Address Route 2, Great Bend, Kansas
Character of Well (completed as Oil, Gas or Dry Hole) Oil
Date well completed April, 9 19 52
Application for plugging filed October 31 19 58
Application for plugging approved November 3 19 58
Plugging commenced December 2 19 58
Plugging completed December 5 19 58
Reason for abandonment of well or producing formation Depletion of
producibile zones
If a producing well is abandoned, date of last production October 31 19 58
Was permission obtained from the Conservation Division or its agents before plugging was commenced? Yes

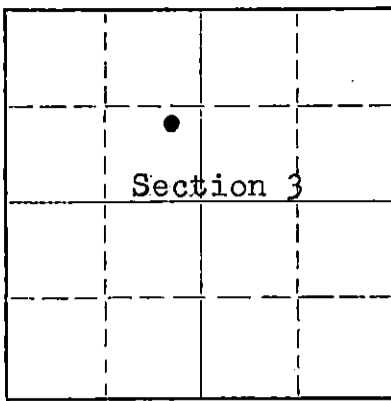

Locate well correctly on above Section Plat

Name of Conservation Agent who supervised plugging of this well Frank Broadfoot
Producing formation Arbuckle Depth to top 3750' Bottom _____ Total Depth of Well 3762 1/2' Feet
Show depth and thickness of all water, oil and gas formations.

OIL, GAS OR WATER RECORDS

CASING RECORD

FORMATION	CONTENT	FROM	TO	SIZE	PUT IN	PULLED OUT
Arbuckle	Water and little oil	3752'	3762 1/2'	8 5/8" 5 1/2"	275' 3752'	None 3175'

Describe in detail the manner in which the well was plugged, indicating where the mud fluid was placed and the method or methods used in introducing it into the hole. If cement or other plugs were used, state the character of same and depth placed, from _____ feet to _____ feet for each plug set.

Filled hole with crushed rock from 3762 1/2' to 3740'. Place 5 sacks cement on top of rock. Mud up to 240' and build solid rock bridge. Place 20 sacks cement on top of rock bridge. Mud up to 40' and build solid rock bridge. Fill hole to base of well, cellar with 10 sacks cement.

(If additional description is necessary, use BACK of this sheet)

Name of Plugging Contractor Morgan Well Plugging Service
Address 102 W. 18th Street, Hutchinson, Kansas

STATE OF Kansas, COUNTY OF Barton, ss.
Don Searle (employee of owner) or ~~owner or operator~~ of the above-described well, being first duly sworn on oath, says: That I have knowledge of the facts, statements, and matters herein contained and the log of the above-described well as filed and that the same are true and correct. So help me God.

(Signature) Don Searle
Route 2, Great Bend, Kansas
(Address)

SUBSCRIBED AND SWORN TO before me this 10th day of December 19 58

My commission expires July 11, 1960

[Signature]
Notary Public.

PLUGGING
FILE SEC. 3 T. 22 R. 13W
BOOK PAGE 141 LINE 4

RECEIVED
STATE CORPORATION COMMISSION

DEC 13 1958

12-13-58

CONSERVATION DIVISION
Wichita, Kansas

DRILLER'S LOG GATES 'B' #1

Petroleum, Inc., Lease Owner
 Garvey Drilling Company, Contractor
 Drilling Commenced: March 9, 1952
 Drilling Completed: March 20, 1952
 Casing Record: 8 5/8" @ 275 w/175 sax
 5 1/2" @ 3752' w/75 sax

Section 3, Twp. 22S, Rge. 13W
 Location: NE SE NW
 County: Stafford
 R.T.D. 3760'
 Elevation: 1893 R.B.

Figures below indicate bottom of formation:

180	Sand
190	Sand Rock
220	Sand
300	Shale & Shells
700	Red Bed, Shale & Shells
730	Red Bed
760	Anhydrite
1520	Shale & Shells
2185	Lime & Shale
2192	Shale & Shells
2380	Shale & Lime
2580	Shale, Lime & Shells
2755	Shale & Shells
3115	Lime & Shale
3573	Lime
3635	Shale & Lime
3675	Cherty Conglomerate & Viola
3702	Viola
3711	Shale & Simpson
3750	Simpson
3760	Lime
3760'	R.T.D.

Tops:

Heebner: 3230 (-1337)
 Brown Lime: 3359 (-1466)
 Lansing: 3377 (-1484)
 Conglomerate: 3635 (-1742)
 Viola: 3644 (-1751)
 Simpson: 3701 (-1808)
 Arbuckle: 3750 (-1857)

RECEIVED
 STATE CORPORATION COMMISSION

DEC 13 1958

CONSERVATION DIVISION
 Wichita, Kansas

I hereby certify that this is a true and correct log of the above mentioned well.

PLUGGING			
FILE	SEC	T. 22	R. 13W
BOOK	PAGE	141	LINE 4

PETROLEUM, INC.

By Charlotte Herdman

STATE OF KANSAS)
) SS:
 COUNTY OF SEDGWICK)

Subscribed to and sworn to before me, a Notary Public, in said County and State, this 1st day of April, 1952.

My commission expires: October 27, 1952.

Marjorie Bradshaw
 Notary Public