

STATE OF KANSAS
STATE CORPORATION COMMISSION


WELL PLUGGING RECORD

OR
FORMATION PLUGGING RECORD

Strike out upper line
when reporting plug-
ging of formations.

Give All Information Completely
Make Required Affidavit
Mail or Report to:
Conservation Division
State Corporation Commission
806 State Building
Wichita, Kansas

NORTH

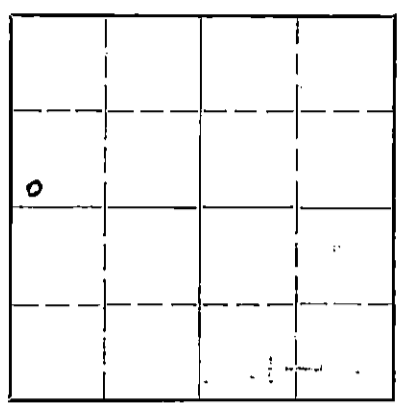

Locate well correctly on above
Section Plat

Stafford County, Sec. 3 Twp. 22 Rge. (E) 13 (W)

Location as "NE 1/4 NW 1/4 SW 1/4" or footage from lines 330' from S. & 330' from W.
Lease Owner W. P. Faulkner
Lease Name Gates Well No. 1
Office Address 409 First National Bank Bldg., Wichita, Kansas
Character of Well (completed as Oil, Gas or Dry Hole) Dry Hole
Date well completed December 10, 1944
Application for plugging filed December 10, 1944
Application for plugging approved December 10, 1944
Plugging commenced December 11, 1944
Plugging completed 1944
Reason for abandonment of well or producing formation Dry Hole

If a producing well is abandoned, date of last production 19
Was permission obtained from the Conservation Division or its agents before plugging was commenced? Yes

Name of Conservation Agent who supervised plugging of this well H. W. Kerr
Producing formation Depth to top Bottom Total Depth of Well 3797 Feet
Show depth and thickness of all water, oil and gas formations.

OIL, GAS OR WATER RECORDS

CASING RECORD

Formation	Content	From	To	Size	Put In	Pulled Out
Arbuckle Lime	Dry Hole			8 5/8"	260'	None

Describe in detail the manner in which the well was plugged, indicating where the mud fluid was placed and the method or methods used in introducing it into the hold. If cement or other plugs were used, state the character of same and depth placed, from feet to feet for each plug set.

Hole filled with rotary mud from 3797' - 260' cement plug from 260' to 240'
rotary mud from 240' to 20' cement plug from 20' to 5' bottom of cellar

FILE 3-22-134 1-3-45
BOOK 143
JAN 2 1945
(If additional description is necessary, use BACK of this sheet)

Correspondence regarding this well should be addressed to W. P. Faulkner
Address 409 First National Bank Building, Wichita 2, Kansas

STATE OF Kansas, COUNTY OF Sedgwick, ss. W. P. Faulkner

(owner or operator) or (owner or operator) of the above-described well, being first duly sworn on oath, says: That I have knowledge of the facts, statements and matters herein contained and the log of the above-described well as filed and that the same are true and correct. So help me God.

(Signature) W. P. Faulkner
409 First National Bank Bldg., Wichita, Kansas
(Address)

SUBSCRIBED AND SWORN to before me this 15th day of December, 1944

Eloise Russell
Notary Public.

My commission expires January 14, 1948

WELL LOG

Company: W. P. Faulkner
 Lease: Gates #1
 County: Stafford
 Driller: Campbell & Kuhn
 Well commenced: November 17th, 1944
 Well finished: December 10, 1944

From	To	
0	9	Cellar
9	235	Sand
235	260	Sand Rock
260	272	Sand rock
272	390	Red Bed
390	750	Red Bed
750	762	Anhydrite
762	868	Red Bed
868	1520	Shale & Shells
1520	1600	Lime & Shale
1600	1690	Shale & Shells
1690	1709	Anhydrite
1709	1780	Lime & Shale
1780	1830	Lime
1830	1960	Lime & Shale
1960	2003	Sand
2003	2140	Shale & Lime
2140	2162	Lime
2162	2556	Lime & Shale
2556	2647	Shale
2647	2738	Shale & Lime
2738	2800	Shale
2800	2850	Shale & Lime
2850	2966	Shale
2966	3055	Lime & Shale
3055	3067	Lime
3067	3131	Shale
3131	3170	Shale & Lime
3170	3200	Lime
3200	3258	Shale & Lime
3258	3292	Shale & Lime
3292	3393	Shale
3393	3449	Lime
3449	3589	Shale & Lime
3589	3628	Lime
3628	3650	Shale
3650	3664	Cherty Cong.
3664	3711	Chert
3711	3762	Shale
3762	3785	Arbuckle
3785	3769	Dolemite
3769	3797	Chert & Lime-T.D.

CERTIFICATION

STATE OF KANSAS)
 COUNTY OF SEDGWICK) SS

I, the undersigned, being duly sworn on oath state that the above statement and log is a true and correct record and log of the well drilled at the location above described.

CAMPBELL & KUHN

By Walter Kuhn
 Walter Kuhn

Subscribed and sworn to before me this 15th day of December, 1944.

PLUGGING

FILE SEC 3 T 22 R 13w
 BOOK PAGE 143 LINE 6

My commission expires June 25, 1948

Leota Johnson
 Notary Public