


STATE OF KANSAS
STATE CORPORATION COMMISSION

WELL PLUGGING RECORD

Give All Information Completely.
Make Required Affidavit
Mail or Deliver Report to
Conservation Division
State Corporation Comm.
245 North Water
Wichita, KS 67202

Stafford County, Sec. 3 Twp. 22 Rge. 13
Location as "NE/CNW $\frac{1}{4}$ SW $\frac{1}{4}$ " or footage from lines
NE SW NE
Lease Owner Poor Boy Corporation
Lease Name Kisner "B" Well No. 4
Office Address R. R. #2 Ellinwood, Kansas 67526
Character of Well (Completed as Oil, Gas or Dry Hole)

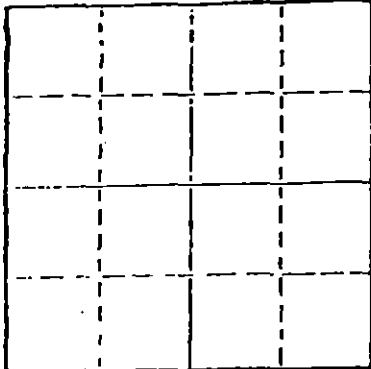

dry hole
Date Well completed Nov. 19 1980
Application for plugging filed Nov. 19 1980
Application for plugging approved Nov. 19 1980
Plugging commenced Nov. 19 1980
Plugging completed Nov. 19 1980
Reason for abandonment of well or producing formation
dry hole

If a producing well is abandoned, date of last production 19

Was permission obtained from the Conservation Division or its agents before plugging was commenced? yes

Name of Conservation Agent who supervised plugging of this well Wm T. Owen
Producing formation Depth to top Bottom Total Depth of Well 3770
Show depth and thickness of all water, oil and gas formations.

OIL, GAS OR WATER RECORDS

CASING RECORD

FORMATION	CONTENT	FROM	TO	SIZE	PUT IN	PULLED OUT
				8 5/8	295	

Describe in detail the manner in which the well was plugged, indicating where the mud fluid was placed and the method or methods used in introducing it into the hold. If cement or other plugs were used, state the character of same and depth placed, from feet to feet for each plug set.

1st plug 480 /40 sx.
2nd plug 300 /40 sx.
3rd plug 40 /10 sx.

10 sx in rathole

12-2-80

(If additional description is necessary, use BACK of this sheet)

Name of Plugging Contractor Woodman & Iannitti Drilling Co.

RECEIVED
COMMISSION
DEC - 2 1980
CONSERVATION DIVISION
Wichita, Kansas

STATE OF KANSAS COUNTY OF SEDGWICK

K. T. Woodman

(employee of owner) or (owner or operator)

of the above-described well, being first duly sworn on oath, says: That I have knowledge of the facts, statements, and matters herein contained and the log of the above-described well as filed and that the same are true and correct. So help me God.

(Signature)

K. T. Woodman

1008 Douglas Bldg. 104 So. Broadway
(Address)

SUBSCRIBED AND SWORN TO before me this 1st day of December, 19 80

My commission expires Feb. 11, 1984

Justina Chamberlain
Notary Public.

K. T. WOODMAN
 RES. PHONE 733-0418
 OFF. PHONE 265-7650
 WICHITA, KANSAS

D. J. IANNITTI
 PHONE 792-2921
 GREAT BEND, KANSAS

WOODMAN & IANNITTI DRILLING COMPANY

Rotary Drilling Contractors

1008 DOUGLAS BUILDING
 104 S. BROADWAY
 WICHITA, KANSAS 67202

December 1, 1980

Company;	Poor Boy Corporation
Farm;	#4 Kisner "B"
Location;	NE SW NE
Section;	3-22-13W
County;	Stafford
Contractor;	Woodman & Iannitti Drilling Co.
Total Depth;	3770'
Comm;	November 14, 1980
Compl;	November 19, 1980
Casing;	8 5/8 @ 295 w/225
Production;	D & A

Figures Indicate Bottom Of Formations;

295	Surface
1115	Redbed & shale
1550	Shale
1881	Line & shale
2785	Shale & lime
3445	Lime & shale
3590	Lime & shale
3665	Lime
3770	Lime & shale

I certify the above to be a true and correct copy of the drillers log to the best of my knowledge and belief.

Woodman & Iannitti Drilling Co.

K. T. Woodman
 K. T. Woodman

RECEIVED
 DEC - 2 1980
 CONSERVATION DIVISION
 Wichita, Kansas