


WELL PLUGGING RECORD

Give All Information Completely
Make Required Affidavit
Mail or Deliver Report to:
Conservation Division
State Corporation Commission
800 Britting Building
Wichita, Kansas

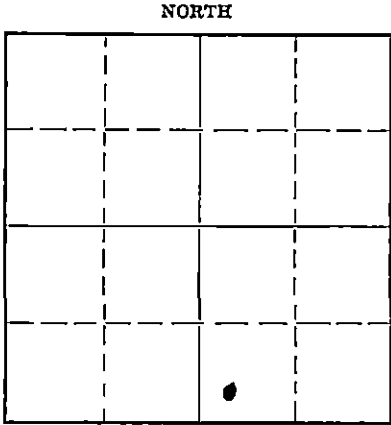

Locate well correctly on above
Section Plat

Stafford County. Sec. 3 Twp. 22S Rge. 13 (E) (W)
Location as "NE/CNW $\frac{1}{4}$ SW $\frac{1}{4}$ " or footage from lines SW/4 SW/4 SE/4
Lease Owner Messrs. J. A. Davis & J. H. Child, et al
Lease Name Kisner Well No. 2
Office Address 121 West Second, Hutchinson, Kansas
Character of Well (completed as Oil, Gas or Dry Hole) Dry Hole
Date well completed August 1 19.50
Application for plugging filed August 2 19.50
Application for plugging approved August 2 19.50
Plugging commenced August 2 19.50
Plugging completed August 2 19.50
Reason for abandonment of well or producing formation Dry Hole

If a producing well is abandoned, date of last production.....19.....
Was permission obtained from the Conservation Division or its agents before plugging was commenced?.....Yes.....

Name of Conservation Agent who supervised plugging of this well.....G. D. Stough.....
Producing formation..... Depth to top..... Bottom..... Total Depth of Well.....3825' Feet
Show depth and thickness of all water, oil and gas formations.

OIL, GAS OR WATER RECORDS

CASING RECORD

Formation	Content	From	To	Size	Put In	Pulled Out
				8-5/8"	320'	

Describe in detail the manner in which the well was plugged, indicating where the mud fluid was placed and the method or methods used in introducing it into the hole. If cement or other plugs were used, state the character of same and depth placed, from.....feet to.....feet for each plug set.

Filled with heavy mud to 310'. Set plug.
Ran 15 sacks cement through drill pipe.
Filled with mud to 30'. Set plug. Ran 10 sacks cement.

*Rec'd
8-10-50*

(If additional description is necessary, use BACK of this sheet)

Correspondence regarding this well should be addressed to Sterling Drilling Company
Address Sterling, Kansas


STATE OF Kansas, COUNTY OF Rice, ss.
Rollin Mead (employee of owner) or (owner or operator) of the above-described well,
being first duly sworn on oath, says: That I have knowledge of the facts, statements, and matters herein contained and the log of the above-described well as filed and that the same are true and correct. So help me God.

(Signature) *Rollin Mead*
Sterling, Kansas
(Address)

SUBSCRIBED AND SWORN TO before me this 3rd day of August, 1950.

J. M. Mullen
Notary Public.

My commission expires My Commission Expires Sept. 17, 1953

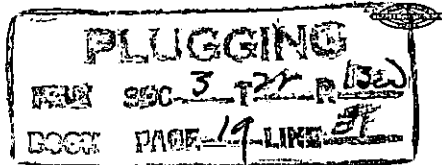

STERLING DRILLING COMPANY

STERLING, KANSAS

WELL LOG ----- KISNER NO. 2

Location - SW. SW SE of Section 3-22S-13W, Stafford County, Kansas.

Owner - Messrs. J. A. Davis and J. H. Child et al
Contractor - Sterling Drilling Company

Commenced - 7-21-50
Completed - 8-1-50 (w/r)

ELEVATION: DF 1893
Gr 1891

Total Depth - 3825' (w/r)

LOG

0- 280	Sand
280- 745	Red Bed
745- 765	Anhydrite
765-1000	Shale and Shells
1000-1540	Shale
1540-1600	Shale and Lime
1600-1735	Lime
1735-2025	Shale and Lime
2025-2190	Lime
2190-2225	Shale
2225-2485	Lime and Shale
2485-2725	Shale and Shells
2725-3260	Lime
3260-3360	Lime and Shale
3360-3742	Lime
3742-3765	Simpson Shale
3765-3782	Shale
3782-3825	Arbuckle

CASING RECORD

320 Ft. of 8-5/8" Surface Pipe
Cemented with 250 Sacks Cement
(1 ft. off bottom)

FORMATION TOPS

Lansing	3390
Conglomerate	3672
Viola	3690
Simpson	3741
Arbuckle	3802

PRODUCTION: Dry and Abandoned

TO WHOM IT MAY CONCERN: This is to certify that the above is a true record of Drilling Well Log of the Kisner No. 2 well.

Signed: STERLING DRILLING COMPANY

PLUGGING
 FILE SEC 3 T 27 R 12
 BOOK PAGE 19 LINE 31

By Rollin Mead
 Rollin Mead - President
 Conservation

Subscribed and sworn to before me this
9th day of August, 1950.

My Commission Expires:

W. L. Dineen
 Notary Public

AUG 10 1950
 STATE CORPORATION
 COMMISSION
 KANSAS