

15-185-30326-0000


STATE OF KANSAS
STATE CORPORATION COMMISSION

Form CP-4

Give All Information Completely
Make Required Affidavit
Mail or Deliver Report to:
Conservation Division
State Corporation Commission
212 No. Market
Wichita, Kansas

WELL PLUGGING RECORD

NORTH

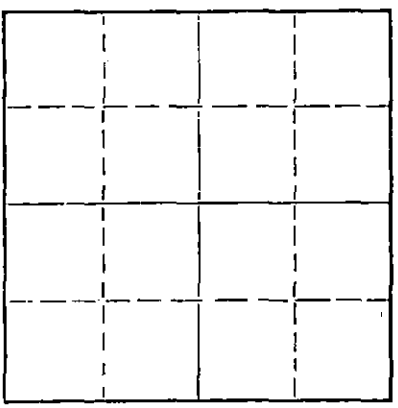

Locate well correctly on above
Section Plat

Stafford County. Sec. 16 Twp. 23S. Rge. 13W (E) (W)
Location as "NE/CNW/SW" or footage from lines. S 1/2 SE NW

Lease Owner Jay Kornfeld
Lease Name Aitken Well No A-#5
Office Address 623 Union Nat'l Bldg., Wichita, Ks.
Character of Well (completed as Oil, Gas or Dry Hole) Dry Hole
Date well completed 9-4-66 19
Application for plugging filed 9-4-66 19
Application for plugging approved 9-4-66 19
Plugging commenced 9-4-66 19
Plugging completed 9-4-66 19
Reason for abandonment of well or producing formation Dry Hole

If a producing well is abandoned, date of last production 19
Was permission obtained from the Conservation Division or its agents before plugging was commenced? yes

Name of Conservation Agent who supervised plugging of this well Herman Justice, residence unknown
Producing formation Depth to top Bottom Total Depth of Well 3717 Feet
Show depth and thickness of all water, oil and gas formations.

OIL, GAS OR WATER RECORDS

CASING RECORD

FORMATION	CONTENT	FROM	TO	SIZE	PUT IN	PULLED OUT
				8 5/8"	188'	none

Describe in detail the manner in which the well was plugged, indicating where the mud fluid was placed and the method or methods used in introducing it into the hole. If cement or other plugs were used, state the character of same and depth placed, from feet to feet for each plug set.

Set 1st Plug @ 160' w/25 sks. cement
Set 2nd Plug @ 40' bridged w/1/2 sk. hulls, 10 sks. cement

RECEIVED
STATE CORPORATION COMMISSION
SEP 9 1966
9-9-66
CONSERVATION DIVISION
Wichita, Kansas

(If additional description is necessary, use BACK of this sheet)
Name of Plugging Contractor Leben Drilling, Inc.
Address Box 486, Great Bend, Kansas 67530

STATE OF KANSAS, COUNTY OF BARTON, ss.
Leslie Kite (employee of owner) or (owner or operator) of the above-described well, being first duly sworn on oath, says: That I have knowledge of the facts, statements, and matters herein contained and the log of the above-described well as filed and that the same are true and correct. So help me God.

(Signature) Leslie Kite
Box 486, Great Bend, Kansas 67530
(Address)

SUBSCRIBED AND SWORN TO before me this 8th day of September, 19 66

My commission expires April 1, 1967
Ulanda Nichols Notary Public.

15-185-30326-0000

DRILLER'S LOG

COMPANY: Jay Kornfeld
 CONTRACTOR: LEBEN DRILLING, INC.
 FARM: AITKEN A-#5
 LOCATION: S½ SE NW SEC. 16-23S-13W
 STAFFORD COUNTY, KANSAS
 COMMENCED: 8-29-66
 COMPLETED: 9-4-66

0	110	Sand
110	440	Shale
440	770	Redbed
770	790	Anhydrite
790	1675	Shale
1675	2340	Lime, Shale
2340	3260	Shale, Lime
3260	3320	Lime
3320	3475	Lime, Shale
3475	3717	Lime
	<u>3717</u>	<u>RTD - D. & A.</u>

8 5/8" 28# used surface casing Set @ 188' cemented with 180 sacks
 Common, 2% cc

I, Leslie Kite, do hereby certify that the above and foregoing, is
 a true and correct copy of the log of the Aitken A-#5 Well, located
 South Half (S½) Southeast (SE) Northwest (NW) of Section 16, Town-
 ship 23 South, Range 13 West, Stafford County, Kansas, as reflected
 by the records of Leben Drilling, Inc.

Leslie Kite
 Leslie Kite

STATE OF KANSAS)
) SS
 COUNTY OF BARTON)

Subscribed and sworn to and before me, a Notary Public, in
 and for Barton County, Kansas, this 8th day of September, 1966.

Ulanda Nichols
 Ulanda Nichols

My Commission Expires:
 April 1, 1967

RECEIVED
 STATE CONSERVATION COMMISSION

SEP 9 1966

CONSERVATION DIVISION
 Wichita, Kansas