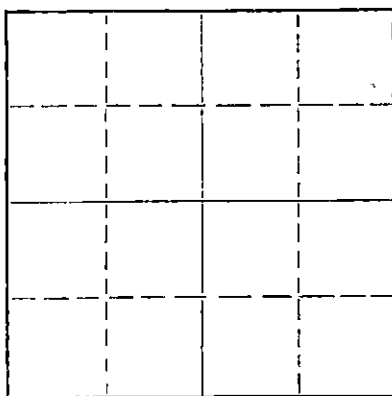


Give All Information Completely
Make Required Affidavit
Mail or Deliver Report to:
Conservation Division
State Corporation Commission
212 No. Market
Wichita, Kansas

WELL PLUGGING RECORD 15-185-00351-0001

NORTH

Locate well correctly on above
Section Plat

Stafford County. Sec. 16 Twp. 23 Rge. 13 (E) W (W)
Location as "NE/CNW/SW" or footage from lines SW SW NW
Lease Owner Specter Pipe & Supply, Inc.
Lease Name Aitken Well No. 1
Office Address Box 169, Russell, Kansas
Character of Well (completed as Oil, Gas or Dry Hole) Oil
Date well completed 9-26-59 19
Application for plugging filed 3-10-68 19
Application for plugging approved 3-11-68 19
Plugging commenced 4-8 19 68
Plugging completed 4-12 19 68
Reason for abandonment of well or producing formation Dry

If a producing well is abandoned, date of last production 19
Was permission obtained from the Conservation Division or its agents before plugging was commenced? Yes

Name of Conservation Agent who supervised plugging of this well Ralph Warren
Producing formation arbuckle Depth to top 3912' Bottom 3946' Total Depth of Well 3947 Feet
Show depth and thickness of all water, oil and gas formations.

OIL, GAS OR WATER RECORDS

CASING RECORD

FORMATION	CONTENT	FROM	TO	SIZE	PUT IN	PULLED OUT
				8 5/8	175'	nine
				5 1/2"	3946'	2034.48'

Describe in detail the manner in which the well was plugged, indicating where the mud fluid was placed and the method or methods used in introducing it into the hole. If cement or other plugs were used, state the character of same and depth placed, from feet to feet for each plug set.

Plugged back with sand to 3460ft. 5 sacks of cement.
Set 10 ft. rock bridge at 175 ft, dumped 25 sacks cement, mudded
hole to 40 ft. Set 10 ft rock bridge, topped with 10 sacks cement.

RECEIVED
STATE CORPORATION COMMISSION
APR 17 1968
CONSERVATION DIVISION
Wichita, Kansas

(If additional description is necessary, use BACK of this sheet)
Name of Plugging Contractor Ralph Lynch Casing Pulling Co.
Address RR#4 Great Bend, Kansas

STATE OF Kansas, COUNTY OF Russell, ss.
Specter Pipe & Supply, Inc. (employee of owner) or (owner or operator) of the above-described well, being first duly sworn on oath, says: That I have knowledge of the facts, statements, and matters herein contained and the log of the above-described well as filed and that the same are true and correct. So help me God.

(Signature) Ralph Lynch
Russell, Kansas
(Address)

SUBSCRIBED AND SWORN TO before me this 16th day of April, 1968

My commission expires May 21, 1971

Milma M. Lindahl
Notary Public.

WELL LOG BUREAU—KANSAS GEOLOGICAL SOCIETY
503 East Murdock, Wichita, Kansas

15-185-00351-0001

Company- MUSGROVE PETROLEUM CORP.
Farm- Aitken No. 1

SEC. 16 T. 23 R. 13W
SW SW NW

Total Depth. 3947'

Comm. 9-17-59


Comp. 9-26-59

Shot or Treated.

Contractor. National Drlg. Co.

Issued. 12-5-59

County Stafford
KANSAS

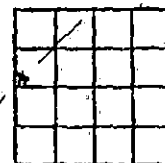

Elevation. 1898' DF

Production. Dry

CASING:

8 5/8" 175' cem w/200 sx.

Figures Indicate Bottom of Formations.

sand	70
shale & shells	1620
lime & shale	2010
lime	2050
lime & shale	3070
lime	3300
lime & shale	3460
lime	3565
lime & shale	3605
lime	3865
lime & shale	3900
lime	3947
Total Depth	

TOPS:	SAMPLE	SCHLUMBERGER
Heebner	3327	3325
Toronto	3347	3345
Douglas	3362	3360
Brown Lime	3464	3462
Lansing	3485	3484
Base Kansas City	3728	3729
Marmaton	3748	3744
Viola	3810	3806
Simpson Shale	3862	3860
Arbuckle	3912	3910

RECEIVED
STATE CORPORATION COMMISSION
MAR 1 1 1968
CONSERVATION DIVISION
Wichita, Kansas