


WELL PLUGGING RECORD

Give All Information Completely
Make Required Affidavit
Mail or Deliver Report to:
Conservation Division
State Corporation Commission
212 North Market, Insurance Bldg.
Wichita, Kansas

Stafford County, Sec. 16 Twp. 23 Rge. (X) 13 (W)

Location as "NE/CNW/SW" or footage from lines SW SW NW
Lease Owner Musgrove Petroleum Corporation
Lease Name Aitken Well No. 1
Office Address 810 Union Center
Character of Well (completed as Oil, Gas or Dry Hole) Dry hole
Date well completed September 26, 19 59
Application for plugging filed September 26, 19 59
Application for plugging approved September 26, 19 59
Plugging commenced September 26, 19 59
Plugging completed September 26, 19 59
Reason for abandonment of well or producing formation Dry hole

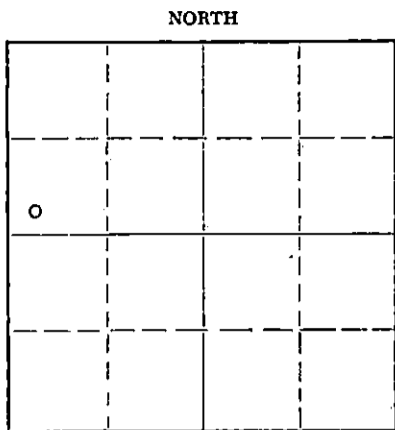

Locate well correctly on above Section Plat

If a producing well is abandoned, date of last production 19
Was permission obtained from the Conservation Division or its agents before plugging was commenced? Yes

Name of Conservation Agent who supervised plugging of this well Frank Broadfoot
Producing formation Depth to top Bottom Total Depth of Well 3947 Feet
Show depth and thickness of all water, oil and gas formations.

OIL, GAS OR WATER RECORDS

CASING RECORD

FORMATION	CONTENT	FROM	TO	SIZE	PUT IN	PULLED OUT
				8 5/8"	175'	None

Describe in detail the manner in which the well was plugged, indicating where the mud fluid was placed and the method or methods used in introducing it into the hole. If cement or other plugs were used, state the character of same and depth placed, from feet to feet for each plug set.

Filled hole from total depth, 3947, to 294' with mud. Cement plug from 294' to 160' with 20 sacks cement. Mud from 160' to 68'. Cement plug from 68' to 35' with 10 sacks cement. Heavy rotary mud from 35' to cellar.

RECEIVED
STATE CORPORATION COMMISSION
OCT 1 1959
CONSERVATION DIVISION
Wichita, Kansas

(If additional description is necessary, use BACK of this sheet)
Name of Plugging Contractor National Drilling Company, Inc.
Address 535 Petroleum Building, Wichita, Kansas

STATE OF KANSAS, COUNTY OF SEDGWICK, ss. Contractor
Howard A. Stoskopf (employee or owner or operator) of the above-described well, being first duly sworn on oath, says: That I have knowledge of the facts, statements, and matters herein contained and the log of the above-described well as filed and that the same are true and correct. So help me God.

(Signature) Howard A. Stoskopf
535 Petroleum Building, Wichita, Kansas
(Address)

SUBSCRIBED AND SWORN TO before me this 28th day of September, 19 59

Ruby Gourley
Notary Public.

RUBY GOURLEY
My commission expires July 13, 1960

My commission expires

15-185-00351-0000

RECEIVED
STATE CORPORATION COMMISSION

OCT 1 1959

CONSERVATION DIVISION
Wichita, Kansas

DRILLERS LOG

Aitken #1

CASING RECORD: 8 5/8" @ 175' w/ 200 sx Sunset

COMPANY: Musgrove Petroleum Corp.

CONTRACTOR: National Drilling Company, Inc.

COMMENCED: September 17, 1959

COMPLETED: September 26, 1959

DESCRIPTION: SW SW NW 16-23S-13W Stafford County Kansas

ELEVATION: 1900 KB 1898 DF

TOTAL DEPTH: 3947 (-2047)

<u>FORMATION</u>	<u>FROM</u>	<u>TO</u>	<u>REMARKS</u>
Sand	0	70	
Shale & Shells	70	1620	
Lime & Shale	1620	2010	
Lime	2010	2050	
Lime & Shale	2050	3070	
Lime	3070	3300	
Lime & Shale	3300	3460	
Lime	3460	3565	
Lime & Shale	3565	3605	
Lime	3605	3865	
Lime & Shale	3865	3900	
Lime	3900	3947	

I certify that this is a true and correct copy of the above log to the best of my knowledge.

NATIONAL DRILLING COMPANY, INC.

Howard A. Stoskopf
 Howard A. Stoskopf, Vice President

Subscribed and sworn to before me this 28th day of September, 1959.

Ruby Gourley
 Notary Public

RUBY GOURLEY
My commission expires July 13, 1960