


15-185-00992-0000

WELL PLUGGING RECORD

Give All Information Completely
Make Required Affidavit
Mail or Deliver Report to:
Conservation Division
State Corporation Commission
800 Bitting Building
Wichita, Kansas

Stafford County, Sec. 18 Twp. 23 S. Rge. 13 (E) (W)

Location as "NE/CNW/SW" or footage from lines NW NW SE
Lease Owner D.R. Lauck Oil Company, Inc.
Lease Name A. French Well No. 1
Office Address 301 South Broadway Wichita 2 Kans
Character of Well (completed as Oil, Gas or Dry Hole) dry hole
Date well completed April 11 19 55
Application for plugging filed April 11 19 55
Application for plugging approved April 11 19 55
Plugging commenced April 11 19 55
Plugging completed April 11 19 55
Reason for abandonment of well or producing formation dry hole

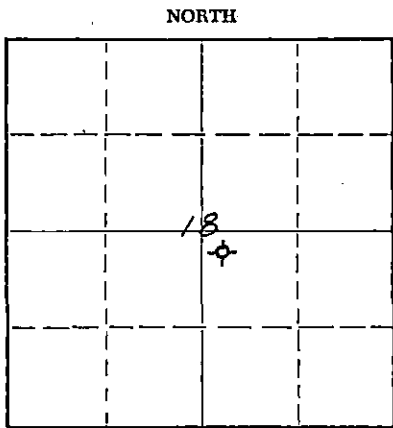

Locate well correctly on above Section Plat

If a producing well is abandoned, date of last production -- 19 --
Was permission obtained from the Conservation Division or its agents before plugging was commenced? YES

Name of Conservation Agent who supervised plugging of this well M. A. Rives
Producing formation -- Depth to top -- Bottom -- Total Depth of Well 4000 Feet
Show depth and thickness of all water, oil and gas formations.

OIL, GAS OR WATER RECORDS

CASING RECORD

FORMATION	CONTENT	FROM	TO	SIZE	PUT IN	PULLED OUT
sand		60	120	8 5/8"	24.7'	none

Describe in detail the manner in which the well was plugged, indicating where the mud fluid was placed and the method or methods used in introducing it into the hole. If cement or other plugs were used, state the character of same and depth placed, from feet to feet for each plug set.

hole filled with mud 4000 - top
plug 245 - 241
80 sax cement 241 - 6' bottom of cellar

RECEIVED
STATE CORPORATION COMMISSION
APR 14 1955 4-14-55
CONSERVATION DIVISION
Wichita, Kansas

(If additional description is necessary, use BACK of this sheet)
Name of Plugging Contractor Globe Oilwell Cementing Co.
Address Great Bend Kansas

STATE OF Kansas, COUNTY OF Sedgwick, ss.
John H. Knightley (employee of owner) ~~owner~~ of the above-described well, being first duly sworn on oath, says: That I have knowledge of the facts, statements, and matters herein contained and the log of the above-described well as filed and that the same are true and correct. So help me God.

(Signature) John H. Knightley
Wichita Kansas
(Address)

SUBSCRIBED AND SWORN TO before me this 13 day of April 19 55

Elizabeth Gay
Notary Public.

My commission expires Sept. 14, 1955

PLUGGING
FILE SEC 18 T 23 R 13W
BOOK PAGE 110 LINE 41

A. French #1

NW NW SE Sec. 18-23S-13W
Stafford County Kansas

Commenced: March 29, 1955
Completed: April 11, 1955

TD: 4,000 casing: 247' 8 5/8" cemented w/200 sacks

Elevation: GR 1902 DF 1905 KB 1907

Drillers Log:

Tops

Sand	120
shale & shells	260
sand	315
red bed & shells	793
Anhydrite	815
shale & shells	1030
salt & shells	1200
shale & shells	1640
shale & Lime	1715
Lime & shale	2595
Shale & shells	2775
Shale & Lime	3295
Lime & shale	3500
Lime	3650
Lime & shale	3672
Lime	3845
Conglomerate-chert	3865
Chert	3898
shale	3940
Lime	3948
Arbuckle	4000

R.T.D. 4,000

Sample		Halliburton
Anhydrite	793 pl 1114	
Heebner	3344 -1437	3342 -1435
Toronto	3361 -1454	3362 -1455
Douglas	3375 -1468	3378 -1471
Br.Lime	3485 -1578	3483 -1476
Lansing	3496 -1589	3496 -1589
Base/KC	3743 -1836	3748 -1841
Marmaton Chert	3770 -1863	3768 -1861
Viola	3853 -1946	3855 -1948
Simpson Shale	3888 -1981	3891 -1984
Arbuckle	3948 -2041	3947 -2040
R.T.D.	4000 -2093	3999 -2092

D & A

- DST #1 (Western) 3650-3672 weak blow 9 min. & died; open 30 min. rec.15' rotary mud; BHP 1220# in 20 min.
- DST#2 (Western) 3856-3865 weak blow in 8 min.& died; open 30 min. rec.10' rotary mud; BHP 0#. 20 min.
- BST #3 (Western) 3946-3950 weak blow in 5 min.& died; open 20 min. rec.5' rotary mud-BHP 720# 20 min.
- DST #4 (Western) 3947-3954 weak blow 42 min & died; open 1 hr. rec.50' very slightly oil-cut muddy water; BHP 1140# 20 min.

PLUGGING
 SEC 18 23 13W
 PAGE 10 LINE 41

RECEIVED
 STATE CONSERVATION COMMISSION

APR 14 1955

CONSERVATION DIVISION
 Wichita, Kansas