


STATE OF KANSAS
STATE CORPORATION COMMISSION

Give All Information Completely
Make Required Affidavit
Mail or Deliver Report to:
Conservation Division
State Corporation Commission
800 Bitting Building
Wichita, Kansas

WELL PLUGGING RECORD

NORTH

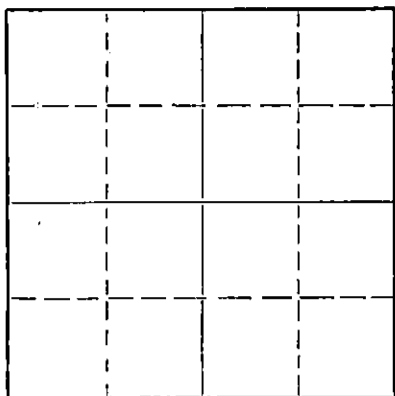

Locate well correctly on above
Section Plat

Stafford County, Sec. 10 Twp. 22 Rge. 13 (E) (W)
Location as "NE/CNW/SW" or footage from lines SE NE SE
Lease Owner Petroleum, Inc.
Lease Name Soeken 'A' Well No. 1
Office Address 305 East Third, Wichita, Kansas
Character of Well (completed as Oil, Gas or Dry Hole) Dry Hole
Date well completed September 1, 1952
Application for plugging filed September 1, 1952
Application for plugging approved September 1, 1952
Plugging commenced September 1, 1952
Plugging completed September 1, 1952
Reason for abandonment of well or producing formation Dry Hole

If a producing well is abandoned, date of last production 19
Was permission obtained from the Conservation Division or its agents before plugging was commenced? Yes

Name of Conservation Agent who supervised plugging of this well Mr. C. D. Stough
Producing formation Depth to top Bottom Total Depth of Well 3800 Feet
Show depth and thickness of all water, oil and gas formations.

OIL, GAS OR WATER RECORDS

CASING RECORD

FORMATION	CONTENT	FROM	TO	SIZE	PUT IN	PULLED OUT
				8 5/8"	267'	None

Describe in detail the manner in which the well was plugged, indicating where the mud fluid was placed and the method or methods used in introducing it into the hole. If cement or other plugs were used, state the character of same and depth placed, from feet to feet for each plug set.

Mudded up to 240' and set wooden plug at 240'. Cemented and displaced 20 sacks cement through drill pipe onto plug at 240'. Mudded up to 35' and set second wooden plug. Filled hole to bottom of well cellar with 10 sacks cement.

RECEIVED
CORPORATION COMMISSION

9-4-52

CONSERVATION DIVISION
Wichita, Kansas

(If additional description is necessary, use BACK of this sheet)

Name of Plugging Contractor Garvey Drilling Company
Address R. R. #2, Great Bend, Kansas

STATE OF KANSAS, COUNTY OF SEDGWICK, ss.
W. W. Fisher (employee of owner) of the above-described well, being first duly sworn on oath, says: That I have knowledge of the facts, statements, and matters herein contained and the log of the above-described well as filed and that the same are true and correct. So help me God.

(Signature) W.W. Fisher
305 East Third, Wichita 2, Kansas (Address)

SUBSCRIBED AND SWORN TO before me this 4th day of September, 1952

My commission expires October 13, 1954 Notary Public.

PLUGGING
FILE SEC 10 TWP 22 R 13
PAGE 4 LINE 32

DRILLER'S LOG SOEKEN #1

Petroleum, Inc., Operator
 Garvey Drilling Company, Contractor
 Drilling Commenced: August 20, 1952
 Drilling Completed: September 1, 1952
 Casing Record: 8 5/8" @ 267' w/175 sex

Section 10, Twp. 22S, Rge. 13W
 Location: SE NE SE
 County: Stafford County, Ks.
 R.T.D.: 3800'
 Production: D & A

Figures below indicate bottom of formations:

90 Sand
 120 Sand & Shale Streaks
 165 Sand
 235 Shale & Shells
 267 Red Bed
 745 Red Shale & Shells
 770 Anhydrite
 1650 Shale & Shells
 1920 Lime & Shale
 2085 Lime
 2185 Lime & Shale
 2635 Shale & Shells
 3385 Shale & Lime
 3640 Lime
 3729 Conglomerate
 3775 Shale & Sand
 3800 Lime
 3800' R.T.D.

Tops:

Heebner: 3242 (-1351)
 Brown Lime: 3371 (-1480)
 Lansing: 3387 (-1496)
 Conglomerate: 3668 (-1777)
 Simpson: 3725 (-1834)
 Arbuckle: 3775 (-1884)

DST #1, 3395-3428, open 1 hr., rec. 48' mud, 1200# BHP.
 DST #2, 3455-69, open 1 hr., rec. 135' water, 950# BHP.
 DST #3, 3475-3520, open 1 hour, rec. 65' water, BHP 1050#.
 DST #4, 3530-84, open 1 hour, rec. 25' mud, BHP 125 #
 DST #5, 3775-80, open 1 hr, rec. 7' mud, 0# BHP.
 DST #6, 3780-95, open 1 hr., rec. 540' gas, 55' muddy oil, 90' heavily oil and gas cut mud, 1250# BHP.
 DST #7, 3795-3800, open 1 hr., rec. 690' slightly gas cut muddy water, 700# BHP.

I hereby certify that this is a true and correct log of the above mentioned well.

PETROLEUM, INC.

BY W.W. Fisher

STATE CORPORATION COMMISSION
 SEP 4 - 1952
 CONSERVATION DIVISION
 Wichita, Kansas

STATE OF KANSAS)
)
 COUNTY OF SEDGWICK)

SS:

Subscribed to and sworn to before me, this 4th day of September, 1952.

PLUGGING
 FILE SEC 10 T 22 R 13D
 BOOK PAGE 41 LINE 32

Charlotte H. ...
 Notary Public

My commission expires: October 13, 1954.