

STATE OF KANSAS
STATE CORPORATION COMMISSION

WELL PLUGGING RECORD

Give All Information Completely
Make Required Affidavit
Mail or Deliver Report to:
Conservation Division
State Corporation Commission
800 Bittling Building
Wichita, Kansas

Stafford County, Sec. 10 Twp. 22S Rge. (E) 13(W)

Location as "NE/CNW $\frac{1}{4}$ SW $\frac{1}{4}$ " or footage from lines SW NE SE

Lease Owner Beardmore Drilling Company

Lease Name Soeken Well No. 1

Office Address 603 Petroleum Building, Wichita 2, Kansas

Character of Well (completed as Oil, Gas or Dry Hole) dry hole

Date well completed March 22 19 53

Application for plugging filed March 22 19 53

Application for plugging approved Mar ch 22 19 53


Plugging commenced March 22 19 53

Plugging completed March 22 19 53

Reason for abandonment of well or producing formation dry hole

If a producing well is abandoned, date of last production 19

Was permission obtained from the Conservation Division or its agents before plugging was commenced? Yes

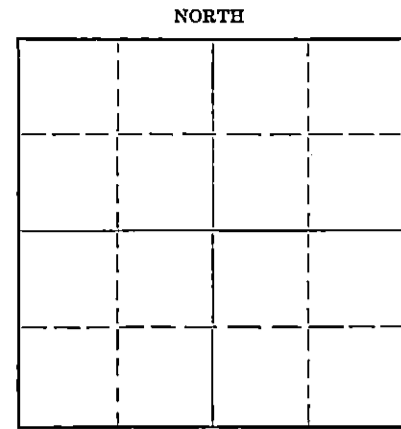

Locate well correctly on above Section Plat

Name of Conservation Agent who supervised plugging of this well C. D. Stough

Producing formation Depth to top Bottom Total Depth of Well 3803 Feet

Show depth and thickness of all water, oil and gas formations.

OIL, GAS OR WATER RECORDS

CASING RECORD

Formation	Content	From	To	Size	Put In	Pulled Out
Sand-Shale-Shells		0	249	8-5/8"	249	-0-

Describe in detail the manner in which the well was plugged, indicating where the mud fluid was placed and the method or methods used in introducing it into the hole. If cement or other plugs were used, state the character of same and depth placed, from top feet to bottom feet for each plug set.

Heavy Mud from 240' to 3803' T.D.

Wood Plug @ 240'

20 Sacks Cement 180' to 240'

Heavy Mud from 35' to 180'

Wood Plug @ 35'

10 Sacks cement - ground level to 35'.

(If additional description is necessary, use BACK of this sheet)

Name of Plugging Contractor Beardmore Drilling Company

Address 603 Petroleum Building, Wichita 2, Kansas

STATE OF KANSAS, COUNTY OF SEDGWICK, SS.

I, Heber Beardmore, (employee of owner) or (owner or operator) of the above-described well, being first duly sworn on oath, says: That I have knowledge of the facts, statements, and matters herein contained and the log of the above-described well as filed and that the same are true and correct. So help me God.

(Signature) Heber Beardmore

603 Petroleum Bldg., Wichita 2, Kansas

(Address)

SUBSCRIBED AND SWORN TO before me this 30th day of March 19 53

My commission expires January 28, 1956

RECEIVED
STATE CORPORATION COMMISSION
Notary Public.

23-8390-s 6-51-20M

PLUGGING
FILE SEC 10 T 22 R 13 W
BOOK PAGE 86 LINE 19

MAR 31 1953
CONSERVATION DIVISION
Wichita, Kansas

SOEKEN NO. 1

SW NE SE
 Section 10-22S-13W
 Stafford County, Kansas

Drilled for: Beardmore & Oil Trading Corp.
 Drilled by: Beardmore Drilling Company

Casing Record:

8-5/8" 249* w/125 Sacks

Drilling Commenced: March 10, 1953
 Drilling Completed: March 22, 1953

Elevation: DF 1890

<u>FORMATION</u>	<u>DEPTH</u>
Sand	210
Shale - Shells	1470
Shale - Lime	1665
Lime	1815
Lime - Shale	2060
Shale - Lime	2240
Lime - Shale	2665
Shale - Lime	2800
Lime - Shale	2935
Lime Broken	3020
Lime	3100
Lime - Shale	3160
Lime	3310
Lime - Shale	3390
Lime	3650
Lime - Shale	3715
Lime	3803 T.D.

D & A

TOPS:	
Heebner	3251
Brown Lime	3379
Lansing	3400
Conglomerate	3663
Viola	3698
Simpson	3732
Arbuckle	3782

DST #1 - 3783-3791 - 55* Oil Cut mud, open 1 hour, shut in 15 minutes, BHP Zero. Weak Blow throughout test.

DST #2 - 3791-3803 - 65* Muddy water, open 1 hour, shut in 15 minutes, BHP 880. Weak blow throughout test.

RECEIVED
 STATE CORPORATION COMMISSION

MAR 31 1953

STATE OF KANSAS
 COUNTY OF SEDGWICK ss

CONSERVATION DIVISION
 Wichita, Kansas

I, the undersigned, being duly sworn on oath state that the above and within statement is a true and correct record and log of the well drilled on the location above-described, to the best of my knowledge and belief.

Handwritten signature

Subscribed and sworn to before me this 30th day of March, 1953.

Handwritten signature
 Notary Public

My Commission Expires:
 January 28, 1956

PLUGGING
 FILE REC 10 T 22 R 13W
 BOOK PAGE 86 LINE 19