


STATE OF KANSAS  
STATE CORPORATION COMMISSION

Give All Information Completely  
Make Required Affidavit  
Mail or Deliver Report to:  
Conservation Division  
State Corporation Commission  
211 N. Broadway  
Wichita, Kansas

WELL PLUGGING RECORD

Stafford County, Sec. 10 Twp. 22 Rge. (E) 13 (W)

Location as "NE/CNW/SW" or footage from lines NW - NW - SW  
Lease Owner Herman George Kaiser, Oil Producer  
Lease Name Hahn Well No. 1  
Office Address Ellinwood, Kansas  
Character of Well (completed as Oil, Gas or Dry Hole)  
Date well completed 19  
Application for plugging filed 19  
Application for plugging approved 19  
Plugging commenced July 25 1958  
Plugging completed August 2 1958  
Reason for abandonment of well or producing formation

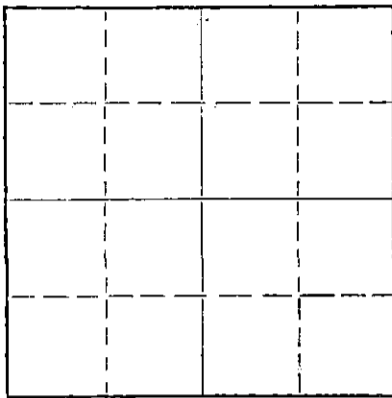

Locate well correctly on above  
Section Plat

If a producing well is abandoned, date of last production 19  
Was permission obtained from the Conservation Division or its agents before plugging was commenced? Yes

Name of Conservation Agent who supervised plugging of this well Frank Brodfoot  
Producing formation \_\_\_\_\_ Depth to top \_\_\_\_\_ Bottom \_\_\_\_\_ Total Depth of Well \_\_\_\_\_ Feet  
Show depth and thickness of all water, oil and gas formations.

OIL, GAS OR WATER RECORDS

CASING RECORD

FORMATION	CONTENT	FROM	TO	SIZE	PUT IN	PULLED OUT
				8 5/8	304	None
				5 1/2	3774	2544.09

Describe in detail the manner in which the well was plugged, indicating where the mud fluid was placed and the method or methods used in introducing it into the hole. If cement or other plugs were used, state the character of same and depth placed, from \_\_\_\_\_ feet to \_\_\_\_\_ feet for each plug set.

Sanded to 3440' - dumped 5 sks cement - mudded hole to 300' - set plug and 10' rock bridge - dumped 2 sks Cal Seal and 1 sk cement - let set - bailed fluid out of hole - let set to see if plug was holding - no fluid returned - dumped 20sks cement - mudded hole to 40' - set 10' rock bridge - dumped 10 sks cement.

(If additional description is necessary, use BACK of this sheet)

Name of Plugging Contractor R & D Casing Pulling Company License # 236  
Address Box 569 Ellinwood, Kansas

STATE OF Kansas, COUNTY OF Barton, ss.  
I, W. J. Hall (employee of owner) or (owner or operator) of the above-described well, being first duly sworn on oath, says: That I have knowledge of the facts, statements, and matters herein contained and the log of the above-described well as filed and that the same are true and correct. So help me God.

(Signature) *W. J. Hall*

(Address)

SUBSCRIBED AND SWORN TO before me this 11 day of August, 1958

*Delmer R. Foster*  
Notary Public.  
8-14-58  
AUG 14 1958

My commission expires \_\_\_\_\_

PLUGGING  
FILE SEC. 10 T. 22 R. 13W  
BOOK PAGE 117 LINE 27

*extra file copy*

WELL LOG

J. D. Ferrell Drilling Co., Inc.,  
 HANN # 1

Sec. 10-22-13W  
 NW NW SW, Stafford Co.

Total Depth: 3776'

Comm: 5-10-49 Comp: 5-24-49

Contractors: J.D.Ferrell Drilling Co., Inc., Elev: 1897 DF  
 Issued 8-27-49 Production: Well

Casing Records: 8 5/8" 304' cemented w/200 sax  
 Bulk Cement  
 5 1/2" 3774' cemented w/200 sax  
 Bulk Cement

Figures Indicate Bottom of Formations:

cellar	5
surface soil & sand	75
sand	150
shale & shells	305
redbed & shale	780
Anhydrite	780
shale & shells	1275
salt & shale	1575
lime & shale	1825
lime	1900
lime & shale	2285
bro. lime	2310
lime & shale	2580
shale & lime	2895
bro Lime	3005
lime	3125
shale & lime	3195
lime	3255
lime & shale	3395
lime	3445
lime K.C.	3485
lime	3585
lime & shale	3680
Cong.chert	3691
chert	3715
chert & shale	3734
shale & sand	3778
Arbuckle	3776
Total Depth	3776

Tops:

K.C.	3381
Cong.	3655
Viola	3601
Simpson Sand	3721
Simpson Shale	3754
Arbuckle	3775
Total Depth	3776

We hereby certify this to be a correct and accurate log of the above described well as shown on the daily Drilling Reports.

J.D.FERRELL DRILLING CO., INC.,

By: J.W. Railsback - Sec. Treas.

Subscribed and sworn to before me this 27th day of Aug., 1949.

My Commission Expires:  
 Oct. 15, 1951

Notary Public

PLUGGING  
 SEC 10 22 13W  
 PAGE 117 OF 27