


STATE OF KANSAS  
STATE CORPORATION COMMISSION

Give All Information Completely  
Make Required Affidavit  
Mail or Deliver Report to:  
Conservation Division  
State Corporation Commission  
800 Bitting Building  
Wichita, Kansas

WELL PLUGGING RECORD

NORTH

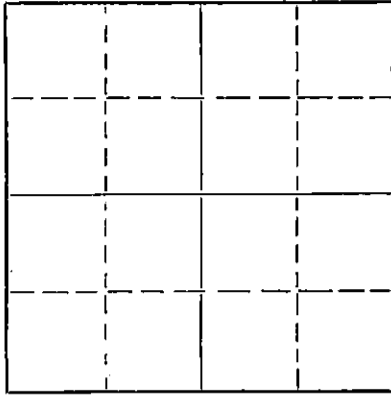

Locate well correctly on above  
Section Flat

Stafford County, Sec. 10 Twp. 22 Rge. 13 (B) (W)  
Location as "NE/CNW/SWK" or footage from lines NE NE NE  
Lease Owner Petroleum, Inc.  
Lease Name Hahn 'B'  
Office Address 305 East Third, Wichita, Kansas  
Character of Well (completed as Oil, Gas or Dry Hole) Dry Hole  
Date well completed August 7, 1952  
Application for plugging filed August 7, 1952  
Application for plugging approved August 7, 1952  
Plugging commenced August 7, 1952  
Plugging completed August 7, 1952  
Reason for abandonment of well or producing formation Dry Hole

If a producing well is abandoned, date of last production 19  
Was permission obtained from the Conservation Division or its agents before plugging was commenced? Yes

Name of Conservation Agent who supervised plugging of this well Mr. M. A. Rives  
Producing formation Depth to top Bottom Total Depth of Well 3738 Feet  
Show depth and thickness of all water, oil and gas formations.

OIL, GAS OR WATER RECORDS

CASING RECORD

FORMATION	CONTENT	FROM	TO	SIZE	PUT IN	PULLED OUT
				8 5/8"	239'	None

Describe in detail the manner in which the well was plugged, indicating where the mud fluid was placed and the method or methods used in introducing it into the hole. If cement or other plugs were used, state the character of same and depth placed, from feet to feet for each plug set.

Mudded up to 230' and set wooden plug at 230'.  
Cemented and displaced 20 sacks cement through  
drill pipe onto plug at 230'. Mudded up to 35  
feet and set second wooden plug. Filled hole to  
bottom of well cellar with 10 sacks cement.

RECEIVED  
STATE CORPORATION COMMISSION

AUG 19 1952

8-19-52

CONSERVATION DIVISION  
Wichita, Kansas

(If additional description is necessary, use BACK of this sheet)

Name of Plugging Contractor Garvey Drilling Company  
Address R. R. #2, Great Bend, Kansas

STATE OF KANSAS, COUNTY OF SEDGWICK, ss.  
Charlotte Weidman (employee of owner) or ~~owner or operator~~ of the above-described well, being first duly sworn on oath, says: That I have knowledge of the facts, statements, and matters herein contained and the log of the above-described well as filed and that the same are true and correct. So help me God.

(Signature) Charlotte Weidman  
305 East Third, Wichita, Kansas  
(Address)

SUBSCRIBED AND SWORN TO before me this 15th day of August, 1952

My commission expires October 27, 1952

Notary Public. *Margorie Bradshaw*

24-2675-5 2-52-20M  
PLUGGING  
FILE SEC 10 T 22 R 130  
BOOK PAGE 36 LINE 14

DRILLER'S LOG HAHN 'B' NO. 1

Petroleum, Inc., Operator	Section 10, Twp. 22S, Rge. 13W
Garvey Drilling Company, Contractor	Location: NE NE NE
Drilling Commenced: July 26, 1952	County: Stafford County, Kansas
Drilling Completed: August 7, 1952	R.T.D.: 3738'
Casing Record: 8 5/8" @ 239' w/175 sax	Production: D & A

Figures below indicate bottom of formation:

50	Surface soil	Tops:
190	Sand	Heebner: 3221 (-1334)
229	Clay	Brown Lime: 3348 (-1461)
239	Shale	Lansing: 3367 (-1480)
730	Red Bed & Shells	Simpson: 3680 (-1793)
757	Anhydrite	Arbuckle: 3733 (-1846)
1625	Shale & Shells	DST #1, 3498-3557, open 1 hr., rec. 30'
3086	Lime & Shale	mud, 60" BHP.
3263	Lime	DST #2, 3617-84, open 30 mins., rec. 30'
3349	Lime & Shale	mud, 0" BHP.
3635	Lime	DST #3, 3658-3710, open 45 mins., rec. 23'
3672	Viola Chert	mud, 42" BHP.
3684	Chert	DST #4, 3734 1/2-38, open 1 hour, rec. 30'
3710	Sed & Shale	watery mud, plus 540' water, BHP 1010#.
3719	Lime & Shale	
3738	Lime	
3738'	R.T.D.	

I hereby certify that this is a true and correct log of the above mentioned well.

PETROLEUM, INC.

By Charlotte Anderson

STATE OF KANSAS )  
 ) SS:  
 COUNTY OF SEDGWICK )

Subscribed to and sworn to before me, a Notary Public, in said County and State, this 18th day of August, 1952.

**PLUGGING**  
 FILE SEC-10-T-27-R (30)  
 PAGE 36 LINE 14

Marjorie Bradshaw  
 Notary Public

My commission expires: October 27, 1952.