

STATE OF KANSAS  
STATE CORPORATION COMMISSION

Form CP-4

15-009-20255-0000

WELL PLUGGING RECORD

Give All Information Completely  
Make Required Affidavit  
Mail or Deliver Report to:  
Conservation Division  
State Corporation Commission  
212 No. Market  
Wichita, Kansas

Barton County, Sec. 4 Twp. 16S Rge. 12W (E) (W)

Location as "NE/CNW/SW" or footage from lines NW SW NW

Lease Owner Robert R. Price

Lease Name Casey Well No. 1

Office Address P. O. Box 45442 Southeast Station, Tulsa, Okla.

Character of Well (completed as Oil, Gas or Dry Hole) dry hole

Date well completed August 11 1968

Application for plugging filed August 28 1968

Application for plugging approved 19  


Plugging commenced August 11 1968

Plugging completed same 19  

Reason for abandonment of well or producing formation dry hole

If a producing well is abandoned, date of last production 19  

Was permission obtained from the Conservation Division or its agents before plugging was commenced? yes

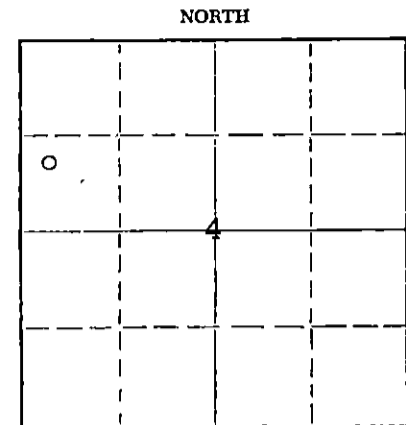

Locate well correctly on above Section Plat

Name of Conservation Agent who supervised plugging of this well Ralph J. Warren

Producing formation \_\_\_\_\_ Depth to top \_\_\_\_\_ Bottom \_\_\_\_\_ Total Depth of Well \_\_\_\_\_ Feet

Show depth and thickness of all water, oil and gas formations.

OIL, GAS OR WATER RECORDS

CASING RECORD

FORMATION	CONTENT	FROM	TO	SIZE	PUT IN	PULLED OUT

Describe in detail the manner in which the well was plugged, indicating where the mud fluid was placed and the method or methods used in introducing it into the hole. If cement or other plugs were used, state the character of same and depth placed, from \_\_\_\_\_ feet to \_\_\_\_\_ feet for each plug set.

Plugged hole thru drill pipe with Pump truck.  
Mud to 480', wood plug, 40 sacks cement.  
Mud to 240', 25 sacks cement  
Mud to 40', 1/2 sack hulls, wood plug and 10 sacks cement.

RECEIVED  
STATE CORPORATION COMMISSION  
AUG 30 1968  
CONSERVATION DIVISION  
Wichita, Kansas

(If additional description is necessary, use BACK of this sheet)

Name of Plugging Contractor Aspen Drilling Co.

Address P. O. Box 783, Great Bend, Kansas

STATE OF Kansas, COUNTY OF Barton, ss.

William S. Schachle (employee of owner) or (owner or operator) of the above-described well, being first duly sworn on oath, says: That I have knowledge of the facts, statements, and matters herein contained and the log of the above-described well as filed and that the same are true and correct. So help me God.


(Signature) William S. Schachle

P. O. Box 783, Great Bend, Kansas  
(Address)

SUBSCRIBED AND SWORN to before me this 28th day of August, 1968

My commission expires April 18, 1972

Theora Holleman  
Theora Holleman Notary Public.

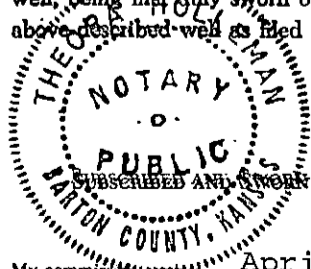

DRILLERS LOG

COMPANY: Robert R. Price  
 CONTRACTOR: Aspen Drilling Co.  
 LEASE NAME: Casey #1  
 LOCATION: NW SW NW Sec. 4-T16S-R12W  
 Barton County, Kansas  
 ELEVATION: 1881 KB  
 SURFACE CASING: 12 jts. (258') 8 5/8"  
 COMMENCED: August 5, 1968  
 COMPLETED: August 11, 1968  
 ROTARY TOTAL DEPTH: 3340'

<u>FORMATION</u>	<u>DEPTH</u>	
Red Bed	266	
Shale	802	
Anhydrite	828	
Shale	1045	Ran 12 jts. (258') 8 5/8" set at
Shale-Shells	1700	265', cemented with 185 sacks
Shale-Lime	1885	Sunset. Cement circulated.
Lime	2030	
Lime-Shale	2325	D & A
Shale-Lime	2600	
Lime-Shale	2855	
Lime	2908	
Lime-Shale	3085	
Lime	3340	

RECEIVED  
 STATE CORPORATION COMMISSION  
 AUG 30 1968  
 CONSERVATION DIVISION  
 Wichita, Kansas

AFFIDAVIT

State of Kansas )  
 ) SS  
 County of Barton )

The undersigned, being duly sworn on oath, states that the above statement and log are a true and correct record and log of the well drilled at the location above described.

William S. Schachle  
 William S. Schachle

and sworn to before me this 28th day of August, 1968.



Theora Holleman  
 Theora Holleman, Notary Public

My commission expires: April 18, 1972