


Give All Information Completely
Make Required Affidavit
Mail or Deliver Report to:
Conservation Division
State Corporation Commission
800 Bitting Building
Wichita, Kansas

Strike out upper line
when reporting plugging
off formations.

NORTH

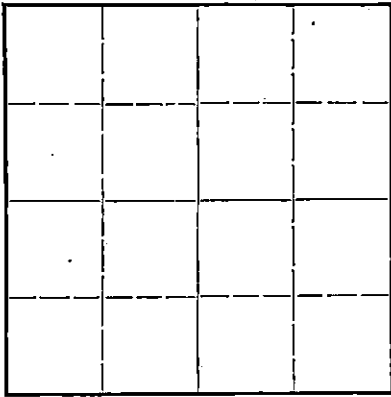

Locate well correctly on above
Section Plot

Barton County. Sec. 4 Twp. 16S. Rge. 12. (W)
Location as "NE 1/4 NW 1/4 SW 1/4" or footage from lines. NW. SE. SE
Lease Owner. The Palmer Oil Corp.
Lease Name. Polzin "C" Well No. 2
Office Address. 415 Union National Bank Bldg., Wichita 2, Kansas
Character of Well (completed as Oil, Gas or Dry Hole). Dry Hole
Date well completed. 2/1 1947
Application for plugging filed. 2/1 1947
Application for plugging approved. 2/1 1947
Plugging commenced. 2/1 1947
Plugging completed. 2/1 1947
Reason for abandonment of well or producing formation. Dry Hole

If a producing well is abandoned, date of last production. 19
Was permission obtained from the Conservation Division or its agents before plugging was commenced? Kerr

Name of Conservation Agent who supervised plugging of this well. Kerr
Producing formation. None Depth to top. Bottom Total Depth of Well. 334.3 Feet
Show depth and thickness of all water, oil and gas formations.

OIL, GAS OR WATER RECORDS

CASING RECORD

Formation	Content	From	To	Size	Put In	Pulled Out
				8 5/8"	162	None

Describe in detail the manner in which the well was plugged, indicating where the mud fluid was placed and the method or methods used in introducing it into the hold. If cement or other plugs were used, state the character of same and depth placed, from feet to feet for each plug set.

158-3343 Heavy Mud
158 Wooden Plug set with drill pipe
115-158 Cement plug 15 sax mixed to slurry and pumped into hole thru drill pipe
38-115 Heavy Mud
38 Wooden plug
Bottom of cellar to 38 cement plug 10 sax cement mixed to slurry and dumped into hole.

(If additional description is necessary, use BACK of this sheet)

Correspondence regarding this well should be addressed to. The Palmer Oil Corporation
Address. 415 Union National Bank Building
Wichita 2, Kansas.

STATE OF Kansas, COUNTY OF Sedgwick, ss.
J. P. McKee (employee of owner) of the above-described well,

being first duly sworn on oath, says: That I have knowledge of the facts, statements, and matters herein contained and the log of the above-described well as filed and that the same are true and correct. So help me God.

(Signature) J. P. McKee

Subscribed and sworn to before me this 7th day of February, 1947.
Notary Public.



FILE REC 4-16-47
BOOK PAGE 96-LINE 12

02-18-47

WELL LOG - POLZIN "C" #2

Well Owner - The Palmer Oil Corporation
 Contractor - The Palmer Oil Corporation

Sec. 4, twp. 16S, rge. 12W
 Location - NW SE SE
 County - Barton County, Kansas
 Elevation - 1860
 I. P. - Dry

Commenced - 1/22/47
 Completed - 2/1/47

Total Depth - 3343

Casing: 8-58/8 - 162' Cem. 75 sax

Surface soil & rock	0	35
Lime & shale	35	255
Shale & Shells	255	340
Sand	340	430
Shale & Sand	430	610
Red Bed	610	685
Shale, Sand, Pyrite	685	710
Shale & Shells	710	778
Anhydrite	778	802
Shale & Shells	802	1220
Salt & Shale	1220	1270
Salt	1270	1345
Shale & Shells	1345	1430
Lime Broken	1430	1520
Lime	1520	1560
Lime Broken	1560	1770
Lime & Shale	1770	2250
Shale & Shells (pyrite)	2250	2310
Shale & Lime	2310	2705
Lime	2705	2975
Shale & Lime	2975	3030
Lime	3030	3343
Total Depth		3343

Formation Tops:

Lansing 3040
 Conglomerate 3314
 Total Depth in
 Conglomerate 3343

I hereby certify that this is a true and correct log of the above-mentioned well.

THE PALMER OIL CORPORATION


J. P. McKee

STATE OF KANSAS)
 COUNTY OF SEDGWICK) SS

Subscribed and sworn to before me, a Notary Public in said County and State, this 7th day of February, 1947.

Bonnie Duvall
 Notary Public

My commission expires 3/21/49.

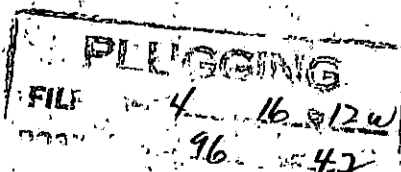

FEB 18 1947