

STATE CORPORATION COMMISSION OF KANSAS
OIL & GAS CONSERVATION DIVISION
WELL COMPLETION OR RECOMPLETION FORM
ACO-1 WELL HISTORY
DESCRIPTION OF WELL AND LEASE

Operator: License # 09408
Name Trans Pacific Oil Corporation
Address 410 One Main Place
City/State/Zip Wichita, KS 67202

Purchaser.....

Operator Contact Person Alan D. Banta
Phone (316) 262-3596

Contractor: License # 05841
Name Trans Pac Drilling, Inc.

Wellsite Geologist Alan D. Banta
Phone (316) 262-3596

Designate Type of Completion
New Well Re-Entry Workover
Oil SWD Temp Abd
Gas Inj Delayed Comp.
X Dry Other (Core, Water Supply etc.)

If ~~OWO~~ old well Info as follows:
Operator
Well Name
Comp. Date Old Total Depth

WELL HISTORY

Drilling Method: Mud Rotary Air Rotary Cable
11/5/88 11/11/88 11/11/88
Spud Date Date Reached TD Completion Date
3800'
Total Depth PBTD

Amount of Surface Pipe Set and Cemented at 321' feet
Multiple Stage Cementing Collar Used? Yes X No
If yes, show depth set.....feet
If alternate 2 completion, cement circulated from.....feet depth to.....w/.....SX cmt
Cement Company Name
Invoice # A-I DYA

API NO. 15-185-22,555-0000
County Stafford
NW SE NW SE
NW NW SE Sec. 12 Twp. 22S Rge. 14 East
1650
1650 Ft North from Southeast Corner of Section
1650 Ft West from Southeast Corner of Section
(Note: Locate well in section plat below)


Lease Name Carver Well # 1

Field Name.....

Producing Formation.....

Elevation: Ground 1924' 1932' KB.....

Section Plat

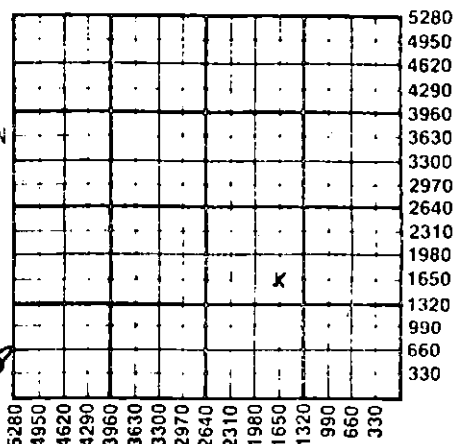

RECEIVED
STATE CORPORATION COMMISSION
DEC 19 1988
CONSERVATION DIVISION
Wichita, Kansas
12-19-88

WATER SUPPLY INFORMATION

Disposition of Produced Water: Disposal
Docket # Repressuring

Questions on this portion of the ACO-1 call:

Water Resources Board (913) 296-3717

Source of Water:
Division of Water Resources Permit # T 88-556

Groundwater.....Ft North from Southeast Corner (Well)Ft West from Southeast Corner of Sec Twp Rge East West

Surface Water.....Ft North from Southeast Corner (Stream, pond etc).....Ft West from Southeast Corner Sec Twp Rge East West


Other (explain)..... (purchased from city, R.W.D. #)

INSTRUCTIONS: This form shall be completed in triplicate and filed with the Kansas Corporation Commission, 200 Colorado Derby Building, Wichita, Kansas 67202, within 120 days of the spud date of any well. Rule 82-3-130, 82-3-107 and 82-3-106 apply. Information on side two of this form will be held confidential for a period of 12 months if requested in writing and submitted with the form. See rule 82-3-107 for confidentiality in excess of 12 months. One copy of all wireline logs and drillers time log shall be attached with this form. Submit CP-4 form with all plugged wells. Submit CP-111 form with all temporarily abandoned wells.

All requirements of the statutes, rules and regulations promulgated to regulate the oil and gas industry have been fully complied with and the statements herein are complete and correct to the best of my knowledge.

Signature Alan D. Banta
Title Vice President Date 11/29/88

Subscribed and sworn to before me this 29th day of November 1988
Notary Public Sondra J. Follis
Date Commission Expires

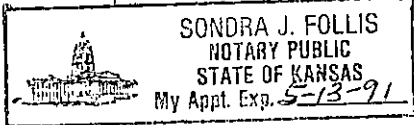

K.C.C. OFFICE USE ONLY
F Letter of Confidentiality Attached
C Wireline Log Received
C Drillers Timelog Received
Distribution
KCC SWD/Rep NGPA
KGS Plug Other (Specify)
12-19-88

Section 18, Twp. 22S, Rge. 14E

Operator Name Trans Pacific Oil Corporation Lease Name Carver Well # 1

Sec. 12 Twp. 22 Rge. 14 East West County Stafford

WELL LOG

INSTRUCTIONS: Show important tops and base of formations penetrated. Detail all cores. Report all drill stem tests giving interval tested, time tool open and closed, flowing and shut-in pressures, whether shut-in pressure reached static level, hydrostatic pressures, bottom hole temperature, fluid recovery, and flow rates if gas to surface during test. Attach extra sheet if more space is needed. Attach copy of log.

Drill Stem Tests Taken Yes No
 Samples Sent to Geological Survey Yes No
 Cores Taken Yes No

Formation Description
 Log Sample

DST #1 3580-3655' Lans 30-20-20-20
 Wk Blo died Rec. 20' M
 ISIP 242# FSIP 86#
 IFP 72-72# FFP 76-76#

Name	Top	Bottom
Anhy.	801	(+1131)
HB	3288	(-1356)
Tor	3310	(-1378)
Doug Sh	3326	(-1394)
Brn Im	3415	(-1483)
Lans	3427	(-1495)
BKC	3659	(-1727)
ARB.	Not Reached	
RTD	3800	(-1868)

CASING RECORD <input type="checkbox"/> New <input type="checkbox"/> Used							
Report all strings set-conductor, surface, intermediate, production, etc.							
Purpose of String	Size Hole Drilled	Size Casing Set (in O.D.)	Weight Lbs/Ft.	Setting Depth	Type of Cement	#Sacks Used	Type and Percent Additives
Surface		8 5/8"		321'	60/40	225	3% CC, 2% GFL
PERFORATION RECORD				Acid, Fracture, Shot, Cement Squeeze Record			
Shots Per Foot	Specify Footage of Each Interval Perforated			(Amount and Kind of Material Used)		Depth	
TUBING RECORD				Liner Run	<input type="checkbox"/> Yes <input type="checkbox"/> No		
Date of First Production	Producing Method						
	<input type="checkbox"/> Flowing <input type="checkbox"/> Pumping <input type="checkbox"/> Gas Lift <input type="checkbox"/> Other (explain).....						
Estimated Production Per 24 Hours	Oil	Gas	Water	Gas-Oil Ratio	Gravity		
	Bbls	MCF	Bbls	CFPB			

METHOD OF COMPLETION

Production Interval

Disposition of gas: Vented Open Hole Perforation
 Sold Other (Specify)
 Used on Lease Dually Completed
 Commingled

Trans Pacific Oil Corporation
410 One Main Place
Wichita, Kansas 67202

DRILLERS LOG

1 Carver
12-22S-14W
Stafford County
Kansas

Spud Date: 11-05-88
Comp. Date: 11-11-88

0-360	Sand Shale
360-1403	Shale
1403-2420	Shale & Lime
2420-3090	Shale & Lime
3090-3520	Lime & Shale
3520-3655	Shale & Lime
3655-3800	Shale & Lime
3800-	RTD

Surface Pipe: Ran 7 jts new 8 5/8" Set at @321'
Cemented w/225 SXS 60/40 Pozmix 3% CC 2% GEL

Plugging: 830' w/50 SXS
330' w/40 SXS
40' w/10 SX

RECEIVED
STATE CORPORATION COMMISSION

AFFIDAVIT

DEC 19 1988

STATE OF KANSAS
COUNTY OF SEDGWICK

CONSERVATION DIVISION
Wichita, Kansas

Alan D. Banta of lawful age does swear and state that the facts and statements herein are true and correct to the best of his knowledge.

Alan D. Banta
Alan D. Banta

Subscribed and sworn to before me this 29th day of November 19 88

My Commission Expires: Sondra J. Follis
Notary Public
Sondra J. Follis

May 13, 1991

