

IN ALL CASES PLOT THE INTENDED WELL ON THE PLAT BELOW

Show the relationship to other wells or facilities proposed to be serviced by the intended cathodic borehole. Please show all the wells, existing cathodic boreholes, pipelines or facilities within 1/2 mile of the proposed borehole.

API NO. 15- _____
 OPERATOR Phillips Pipe Line Company
 LEASE Wichita Station Terminal
 WELL NUMBER #2
 FACILITY NAME Wichita Station Terminal #2

LOCATION OF WELL: COUNTY Sedgwick
3,100' feet from south/north line of section
1,900' feet from east/west line of section
 SECTION 27 TWP 26S RG 1E

SPOT: QTR/QTR/QTR/QTR OF ACREAGE
 _____ - SE - SW - NE

IS SECTION X REGULAR or _____ IRREGULAR
IF SECTION IS IRREGULAR, LOCATE WELL FROM NEAREST CORNER BOUNDARY.
 Section corner used: _____ NE _____ NW _____ SE _____ SW

PLAT

(Show location of intended cathodic borehole.)



(Show footage from nearest lease, unit or outside section boundary line.)

RECEIVED
 KANSAS CORPORATION COMMISSION

JUN 0 4 2004

CONSERVATION DIVISION
 WICHITA, KS

Section 27

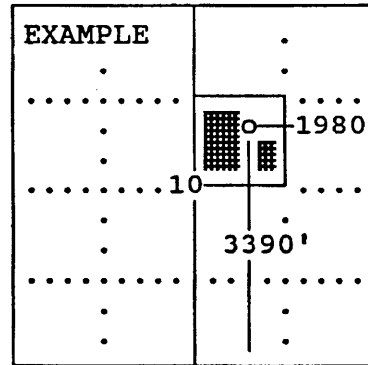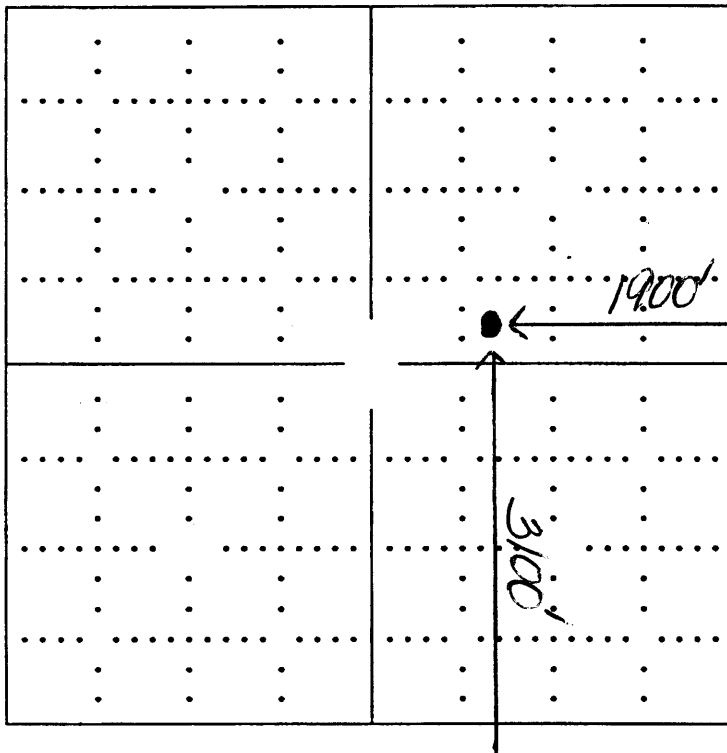

SEWARD CO.

In plotting the proposed location of the well, you must show:

- 1) The manner in which you are using the depicted plat by identifying section lines, i.e. 1 section, 1 section with 8 surrounding sections, 4 sections, etc.;
- 2) the distance of the proposed drilling location from the section's south/north and east/west; and
- 3) the distance to the nearest lease, unit or outside section boundary line.