

REQUEST FOR CHANGE OF OPERATOR
TRANSFER OF INJECTION AUTHORIZATION
OR TRANSFER OF SURFACE POND PERMIT

032000-Adelgren Inj.pdf
KANSAS CORPORATION COMMISSION
CONSERVATION DIVISION
130 S MARKET, ROOM 2078
WICHITA, KANSAS 67202

Check Applicable Boxes:

[x] Oil Lease: No. of Wells 18 **

[] Gas Lease: No. of Wells _____ **

** SIDE TWO MUST BE COMPLETED **

[] Saltwater Disposal Well - Docket No. _____
Spot Location: _____ feet from N/S Line

_____ feet from E/W Line

[x] Enhanced Recovery Proj. Docket No. E-25,414

Entire project: Yes (No)

Number of injection wells 7 **

Field Name Vilas Oil & Gas

Surface Pond Permit # _____
(API No. If Drill Pit)

Identify: Emergency Pit ☐

Burn Pit ☐

Storage Pit ☐

Drill Pit ☐ AB

Effective Date of Transfer 3-20-00

Lease Name Adelgren

____ - ____ - ____ NW Sec 36 T 27 R 16 W E

Legal Description of Lease: NW 1/4 (160

Acres) Section 36 - T27S - R16E

County Wilson

Production Zone(s) Cattleman, Squirrel

Injection Zone(s) Cattleman, Squirrel

____ Feet from N/S Line of Section

____ Feet from E/W Line of Section

Past Operator's License No. 31767

Contact Person: Mark Bolejack

(316) 724-8095

Past Operator's Name and Address:

Seymour Oil Company, Inc.

3101 Columbus Road

Macon, Georgia 31204

Title Geologist/Agent

Phone: _____

Date January 27, 2000

Signature Thomas H. Oast

New Operator's License No. 32187

Contact Person LANCE BALLARD

Phone (316) 468-2885

New Operator's Name and Address

SOUTHWIND EXPLORATION, LLC

P.O. Box 34

AIQUA, KS. 66761

Oil/Gas Purchaser EQUIVA

Date 4.19.00

Title Agent

Signature Lance E. Ballard, Agent

ACKNOWLEDGEMENT OF TRANSFER: The above request for transfer of injection authorization surface pond permit # _____ has been noted, approved and duly recorded in the records of the Kansas Corporation Commission. This acknowledgement of transfer pertains to Kansas Corporation Commission records only and does not convey any ownership interest in the ab injection well(s) or pond permit.

_____ is acknowledged
as the new operator and may continue to
inject fluids as authorized by Docket # _____
Recommended action _____

Date _____

Authorized Signature _____

_____ is acknowledged as
new operator of the above named lease containing
the surface pond permitted by _____

STATE CORPORATION COMMISSION

Date MAY 24 2000

CONSERVATION DIVISION
Wichita, Kansas

Authorized Signature _____

APR 21 2000

Wichita, Kansas Form T1

MUST BE FILED FOR ALL WELLS

*LOCATION: NW $\frac{1}{4}$ Section 36 - T27S - R16EFOOTAGE FROM SECTION LINE
(i.e. FSL=feet from South line)TYPE OF WELL
(OIL/GAS
INJ/MSW)WELL STATUS
(PROD/TA'D
ABANDONED)LEASE NAME Adelgren LeaseWELL NO. API NO.
(YR DRLD/PRE '67)

WELL NO.	API NO.	YR DRLD/PRE '67)	FOOTAGE FROM SECTION LINE (i.e. FSL=feet from South line)	TYPE OF WELL (OIL/GAS INJ/MSW)	WELL STATUS (PROD/TA'D ABANDONED)
6A			2800 <u>circle</u> <u>FSL/FNL</u> <u>5170</u> <u>circle</u> <u>FEL/FWL</u>	<u>Injection</u>	<u>Active</u>
5A			2794 <u>FSL/FNL</u> <u>4863</u> <u>FEL/FWL</u>	<u>oil</u>	<u>Producer</u>
4A			2789 <u>FSL/FNL</u> <u>4547</u> <u>FEL/FWL</u>	<u>oil</u>	<u>Producer</u>
3A			2794 <u>FSL/FNL</u> <u>4263</u> <u>FEL/FWL</u>	<u>oil</u>	<u>Producer</u>
1A			2816 <u>FSL/FNL</u> <u>3976</u> <u>FEL/FWL</u>	<u>oil</u>	<u>Producer</u>
2A			2974 <u>FSL/FNL</u> <u>3642</u> <u>FEL/FWL</u>	<u>oil</u>	<u>Producer</u>
7A			2989 <u>FSL/FNL</u> <u>2937</u> <u>FEL/FWL</u>	<u>oil</u>	<u>Producer</u>
1			4840 <u>FSL/FNL</u> <u>5170</u> <u>FEL/FWL</u>	<u>Injection</u>	<u>Active</u>
2			4495 <u>FSL/FNL</u> <u>5190</u> <u>FEL/FWL</u>	<u>oil</u>	<u>Producer</u>
3			4160 <u>FSL/FNL</u> <u>5160</u> <u>FEL/FWL</u>	<u>Injection</u>	<u>Active</u>
18A			3895 <u>FSL/FNL</u> <u>5180</u> <u>FEL/FWL</u>	<u>oil</u>	<u>Producer</u>
13A			3450 <u>FSL/FNL</u> <u>5160</u> <u>FEL/FWL</u>	<u>Injection</u>	<u>Active</u>
14A			3590 <u>FSL/FNL</u> <u>4757</u> <u>FEL/FWL</u>	<u>oil</u>	<u>Producer</u>
19A			3790 <u>FSL/FNL</u> <u>4840</u> <u>FEL/FWL</u>	<u>Injection</u>	<u>Active</u>
20A			3895 <u>FSL/FNL</u> <u>4387</u> <u>FEL/FWL</u>	<u>oil</u>	<u>Producer</u>
5A			3550 <u>FSL/FNL</u> <u>4990</u> <u>FEL/FWL</u>	<u>Injection</u>	<u>Active</u>

RECEIVED
STATE CORPORATION COMMISSION
MAY 24 2000
CONSERVATION DIVISION
Wichita, Kansas

RECEIVED
STATE CORPORATION COMMISSION
APR 21 2000
CONSERVATION DIVISION
Wichita, Kansas

A SEPARATE SHEET MAY BE ATTACHED IF NECESSARY

MUST BE FILED FOR ALL WELLS

*LEASE NAME

Adelgren Lease

*LOCATION: NW 1/4 Section 36 - T27S - R16E

WELL NO.

API NO.
(YR DRID/PRE '67)

FOOTAGE FROM SECTION LINE
(i.e. FSL=feet from South Line)

TYPE OF WELL
(OIL/GAS
INJ/WSW)

WELL STATUS
(PROD/TA'D
ABANDONED)

9A	Unknown	3285	Circle FSL/FNL	4387	Circle FEL/FWL	oil	Producer
8A		3285	FSL/FNL	3950	FEL/FWL	oil	Producer
16A		3590	FSL/FNL	4037	FEL/FWL	oil	Producer
17A		3590	FSL/FNL	3687	FEL/FWL	oil	Producer
8		5115	FSL/FNL	4757	FEL/FWL	oil	Producer
7		5115	FSL/FNL	4427	FEL/FWL	oil	Producer
4		4850	FSL/FNL	4757	FEL/FWL	oil	Producer
5		4495	FSL/FNL	4757	FEL/FWL	oil	Producer
10A		3150	FSL/FNL	4830	FEL/FWL	Injection	Active
			FSL/FNL		FEL/FWL		
			FSL/FNL		FEL/FWL		
RECEIVED
STATE CORPORATION COMMISSION
MAY 24 2000
CONSERVATION DIVISION
Wichita, Kansas

RECEIVED
STATE CORPORATION COMMISSION
APR 21 2000
CONSERVATION DIVISION
Wichita, Kansas

Township 27S Range 16E County WILSON State KANSAS

NW $\frac{1}{4}$ of SEC 36

ADELGREN LEASE

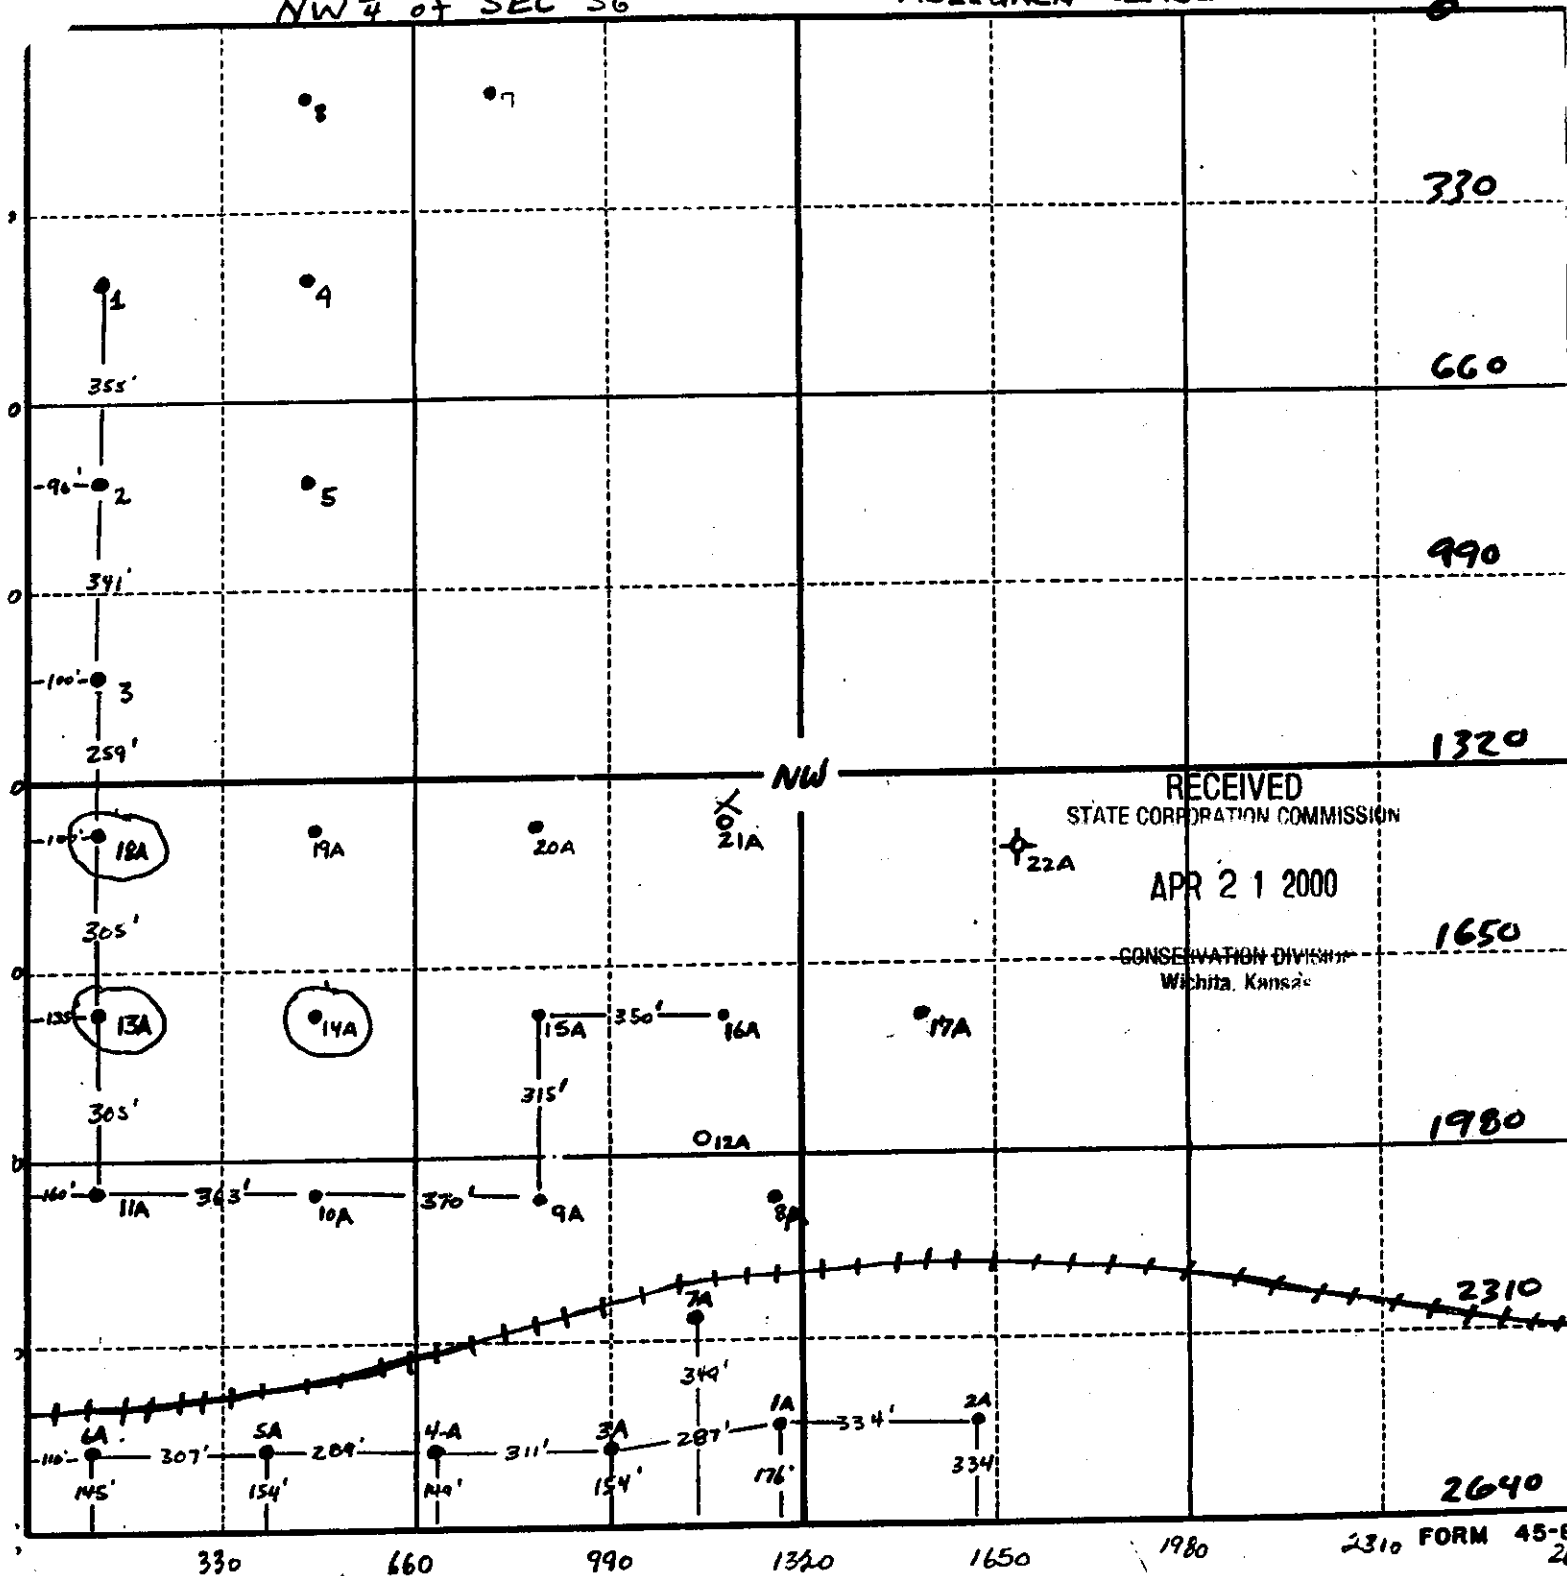

RECEIVED
STATE CORPORATION COMMISSION

MAY 24 2000

CONSERVATION DIVISION
Wichita, Kansas