

KANSAS CORPORATION COMMISSION  
OIL & GAS CONSERVATION DIVISION  
**REQUEST FOR CHANGE OF OPERATOR  
TRANSFER OF INJECTION OR SURFACE PIT PERMIT**

Form T-1  
April 2004  
Form must be Typed  
Form must be Signed  
All blanks must be Filled

Check Applicable Boxes:

- ☒ Oil Lease: No. of Oil Wells 2 \*\*
- ☐ Gas Lease: No. of Gas Wells \_\_\_\_\_ \*\*
- ☐ Gas Gathering System: \_\_\_\_\_
- ☐ Saltwater Disposal Well - Permit No.: \_\_\_\_\_
- Spot Location: \_\_\_\_\_ feet from ☐ N / ☐ S Line  
\_\_\_\_\_ feet from ☐ E / ☐ W Line
- ☐ Enhanced Recovery Project Permit No.: \_\_\_\_\_
- Entire Project: ☐ Yes ☐ No
- Number of Injection Wells \_\_\_\_\_ \*\*

Field Name: \_\_\_\_\_

**\*\* Side Two Must Be Completed.**

Effective Date of Transfer: January 1, 2005

KS Dept of Revenue Lease No.: 134557

Lease Name: Collins Fee

NE/4 - NW/4 - SE/4 - Sec. 4 Twp. 35S R. 15 ☒ E ☐ W

Legal Description of Lease: \_\_\_\_\_

**RECEIVED**

County: Montgomery

**MAR 31 2005**

Production Zone(s): \_\_\_\_\_

Injection Zone(s): \_\_\_\_\_

**KCC WICHITA**

Surface Pit Permit No.: \_\_\_\_\_  
(API No. if Drill Pit, WO or Haul)

Type of Pit: ☐ Emergency ☐ Burn ☐ Settling ☐ Haul-Off ☐ Workover ☐ Drilling

Past Operator's License No. 32887

Past Operator's Name & Address: Endeavor Energy Resources, LP  
10 S. Elm St., P.O. Box 40, Delaware, OK 74027

Title: Autry C. Stephens, Sole Member, Mng Partner

Contact Person: Cheryl Prince

Phone: 432-687-1575

Date: 01-18-05

Signature: *Autry C. Stephens*

**RECEIVED**

**FEB 04 2005**

**KCC WICHITA**

New Operator's License No. 33261

New Operator's Name & Address: Brower Oil & Gas Co, Inc.

6506 S. Lewis Ave., Ste. 115

Tulsa, OK 74136

Vice President/ Sec.

Title: \_\_\_\_\_

Contact Person: Ashley Jones

Phone: 918-743-8893

Oil / Gas Purchaser: Coffeyville Resources

Date: 2/2/05

Signature: *Kurt Jaym Brown*

**Acknowledgment of Transfer:** The above request for transfer of injection authorization, surface pit permit # \_\_\_\_\_ has been noted, approved and duly recorded in the records of the Kansas Corporation Commission. This acknowledgment of transfer pertains to Kansas Corporation Commission records only and does not convey any ownership interest in the above injection well(s) or pit permit.

\_\_\_\_\_ is acknowledged as the  
new operator and may continue to inject fluids as authorized by  
Permit No.: \_\_\_\_\_ . Recommended action: \_\_\_\_\_

Date: \_\_\_\_\_  
Authorized Signature

\_\_\_\_\_ is acknowledged as the  
new operator of the above named lease containing the surface pit  
permitted by No.: \_\_\_\_\_ .

Date: \_\_\_\_\_  
Authorized Signature

DISTRICT \_\_\_\_\_

EPR 4/19/05

PRODUCTION APR 20 2005

UIC 4/20/05

Mail to: Past Operator \_\_\_\_\_

New Operator \_\_\_\_\_

District \_\_\_\_\_

Mail to: KCC - Conservation Division, 130 S. Market - Room 2078, Wichita, Kansas 67202

\* Location: \_\_\_\_\_

\* When transferring a unit which consists of more than one lease please file a separate side two for each lease. If a lease covers more than one section please indicate which section each well is located.

SCALE: 1" = 1000'

DATED MARCH 28, 2005

- TRAVIS NO. 1 - 1505 FEET FROM THE SOUTH LINE AND 2345 FEET FROM THE WEST LINE OF THE NW/4 OF SECTION 4, T35S, R15E, MONTGOMERY COUNTY, KANSAS. ELEVATION = 861.3'
- TRAVIS NO. 2 - 1505 FEET FROM THE SOUTH LINE AND 2040 FEET FROM THE WEST LINE OF THE NW/4 OF SECTION 4, T35S, R15E, MONTGOMERY COUNTY, KANSAS. ELEVATION = 853.3'
- TRAVIS NO. 3 - 1505 FEET FROM THE SOUTH LINE AND 1705 FEET FROM THE WEST LINE OF THE NW/4 OF SECTION 4, T35S, R15E, MONTGOMERY COUNTY, KANSAS. ELEVATION = 849.3'
- TRAVIS NO. 4 - 1870 FEET FROM THE SOUTH LINE AND 1870 FEET FROM THE WEST LINE OF THE NW/4 OF SECTION 4, T35S, R15E, MONTGOMERY COUNTY, KANSAS. ELEVATION = 852.9'
- TRAVIS NO. 5 - 1830 FEET FROM THE SOUTH LINE AND 1700 FEET FROM THE WEST LINE OF THE NW/4 OF SECTION 4, T35S, R15E, MONTGOMERY COUNTY, KANSAS. ELEVATION = 852.3'
- HARDING NO. 1 - 1815 FEET FROM THE SOUTH LINE AND 980 FEET FROM THE WEST LINE OF THE SW/4 OF SECTION 4, T35S, R15E, MONTGOMERY COUNTY, KANSAS. ELEVATION = 850.6'
- HARDING NO. 2 - 40 FEET FROM THE SOUTH LINE AND 1070 FEET FROM THE WEST LINE OF THE NE/4 OF SECTION 4, T35S, R15E, MONTGOMERY COUNTY, KANSAS. ELEVATION = 879.3'
- COLLINS NO. 1 - 2345 FEET FROM THE SOUTH LINE AND 1060 FEET FROM THE WEST LINE OF THE SE/4 OF SECTION 4, T35S, R15E, MONTGOMERY COUNTY, KANSAS. ELEVATION = 881.3'
- COLLINS NO. 2 - 1830 FEET FROM THE SOUTH LINE AND 1020 FEET FROM THE WEST LINE OF THE SE/4 OF SECTION 4, T35S, R15E, MONTGOMERY COUNTY, KANSAS. ELEVATION = 884.9'

CERTIFICATE OF AUTHORIZATION NO. 2434 EXPIRES 6/30/06

**BUCKLAND SURVEYING COMPANY, INC.**  
LAND SURVEYING SERVICES

1602 S.E. WASHINGTON BLVD.

BARTLESVILLE, OKLAHOMA 74006

(918) 336-6071

RECEIVED  
KANSAS CORPORATION COMMISSION

APR 18 2005


CONSERVATION DIVISION  
WICHITA, KS

RECEIVED  
KANSAS CORPORATION COMMISSION

APR 18 2005

CONSERVATION DIVISION  
WICHITA KS

**SECTION 4, TOWNSHIP 35 SOUTH, RANGE 15 EAST  
MONTGOMERY COUNTY, KANSAS.**

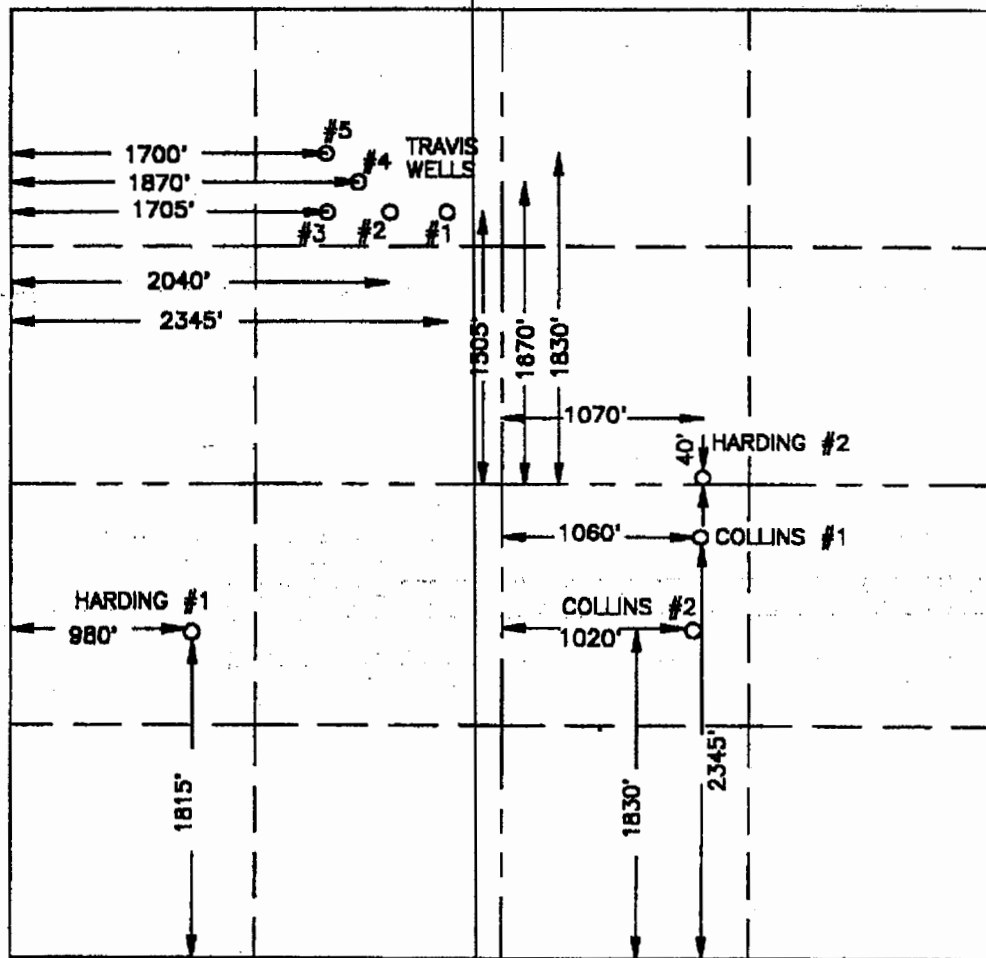

SCALE: 1" = 1000'

DATED MARCH 28, 2005