

KANSAS CORPORATION COMMISSION
OIL & GAS CONSERVATION DIVISION

**REQUEST FOR CHANGE OF OPERATOR
TRANSFER OF INJECTION OR SURFACE PIT PERMIT**

Form T-1

April 2004

Form must be Typed
Form must be Signed
All blanks must be Filled

Check Applicable Boxes:

- ☒ Oil Lease: No. of Oil Wells 2 **
- ☐ Gas Lease: No. of Gas Wells _____ **
- ☐ Gas Gathering System: _____
- ☐ Saltwater Disposal Well - Permit No.: _____
- Spot Location: _____ feet from ☐ N / ☐ S Line
_____ feet from ☐ E / ☐ W Line
- ☐ Enhanced Recovery Project Permit No.: _____
- Entire Project: ☐ Yes ☐ No
- Number of Injection Wells _____ **

Field Name: _____

**** Side Two Must Be Completed.**Effective Date of Transfer: January 1, 2005KS Dept of Revenue Lease No.: 134556Lease Name: HardingSec. 5 Twp. 35 R. 15 ☒ E ☐ WLegal Description of Lease: See backCounty: MontgomeryProduction Zone(s): MAR 31 2005Injection Zone(s): KCC WICHITA**RECEIVED**Surface Pit Permit No.: _____
(API No. if Drill Pit, WO or Haul)_____ feet from ☐ N / ☐ S Line of Section_____ feet from ☐ E / ☐ W Line of Section 430Type of Pit: ☐ Emergency ☐ Burn ☐ Settling ☐ Haul-Off ☐ Workover ☐ DrillingPast Operator's License No. 32887Past Operator's Name & Address: Endeavor Energy Resources, LP
10 S. Elm St., P.O. Box 40, Delaware, OK 74027Title: Autry C. Stephens, Sole Member, Mng PartnerContact Person: Cherl PrincePhone: 432-687-1575Date: 01-18-05

Signature: _____

RECEIVED**FEB 04 2005****KCC WICHITA**New Operator's License No. 33261New Operator's Name & Address: Brower Oil & Gas Co., Inc.
6506 S. Lewis Ave., Ste. 115
Tulsa, OK 74136Title: Vice President/Sec.Contact Person: Ashley JonesPhone: 918-743-8893Oil / Gas Purchaser: Coffeyville ResourcesDate: 2/2/05

Signature: _____

Acknowledgment of Transfer: The above request for transfer of injection authorization, surface pit permit # _____ has been noted, approved and duly recorded in the records of the Kansas Corporation Commission. This acknowledgment of transfer pertains to Kansas Corporation Commission records only and does not convey any ownership interest in the above injection well(s) or pit permit.

_____ is acknowledged as the
new operator and may continue to inject fluids as authorized by
Permit No.: _____. Recommended action: _____

Date: _____
Authorized Signature

_____ is acknowledged as the
new operator of the above named lease containing the surface pit
permitted by No.: _____

Date: _____
Authorized Signature

DISTRICT _____

EPR 4/19/05PRODUCTION APR 20 2005UIC 4/20/05

Mail to: Past Operator _____

New Operator _____

District _____

Mail to: KCC - Conservation Division, 130 S. Market - Room 2078, Wichita, Kansas 67202

* Lease Name: Harding

* Location: Sec 4 355 15E

~~RECEIVED~~

MAR 31 2005

~~KCC WICHITA~~

RECEIVED

FEB 04 2005


KCC WICHITA

* When transferring a unit which consists of more than one lease please file a separate side two for each lease. If a lease covers more than one section please indicate which section each well is located.

RECEIVED
KANSAS CORPORATION COMMISSION
APR 18 2005

SURVEY DIVISION
WICHITA KS

SECTION 4, TOWNSHIP 35 SOUTH, RANGE 16 EAST
MONTGOMERY COUNTY, KANSAS.

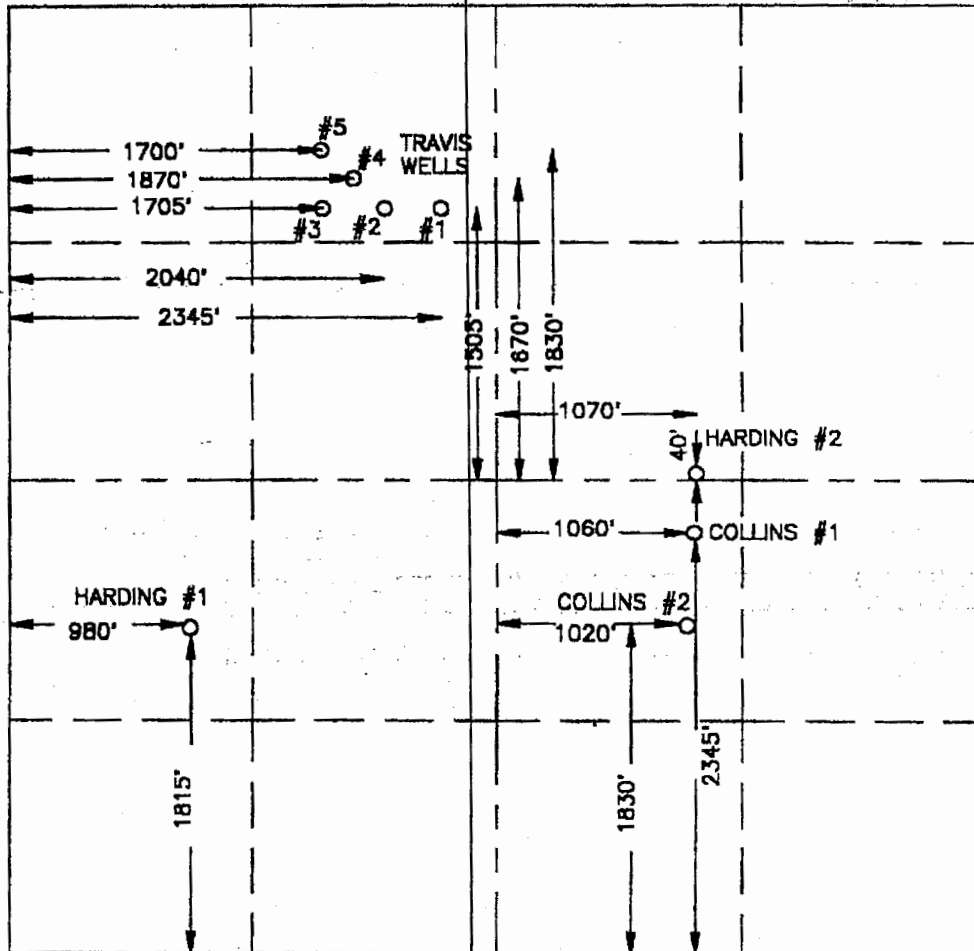

SCALE: 1" = 1000'

DATED MARCH 28, 2005

SCALE: 1" = 1000'

DATED MARCH 28, 2005

- TRAVIS NO. 1 - 1505 FEET FROM THE SOUTH LINE AND 2345 FEET FROM THE WEST LINE OF THE NW/4 OF SECTION 4, T35S, R15E, MONTGOMERY COUNTY, KANSAS. ELEVATION = 861.3'
- TRAVIS NO. 2 - 1505 FEET FROM THE SOUTH LINE AND 2040 FEET FROM THE WEST LINE OF THE NW/4 OF SECTION 4, T35S, R15E, MONTGOMERY COUNTY, KANSAS. ELEVATION = 853.3'
- TRAVIS NO. 3 - 1505 FEET FROM THE SOUTH LINE AND 1705 FEET FROM THE WEST LINE OF THE NW/4 OF SECTION 4, T35S, R15E, MONTGOMERY COUNTY, KANSAS. ELEVATION = 849.3'
- TRAVIS NO. 4 - 1870 FEET FROM THE SOUTH LINE AND 1870 FEET FROM THE WEST LINE OF THE NW/4 OF SECTION 4, T35S, R15E, MONTGOMERY COUNTY, KANSAS. ELEVATION = 852.9'
- TRAVIS NO. 5 - 1830 FEET FROM THE SOUTH LINE AND 1700 FEET FROM THE WEST LINE OF THE NW/4 OF SECTION 4, T35S, R15E, MONTGOMERY COUNTY, KANSAS. ELEVATION = 852.3'
- HARDING NO. 1 - 1815 FEET FROM THE SOUTH LINE AND 980 FEET FROM THE WEST LINE OF THE SW/4 OF SECTION 4, T35S, R15E, MONTGOMERY COUNTY, KANSAS. ELEVATION = 850.6'
- HARDING NO. 2 - 40 FEET FROM THE SOUTH LINE AND 1070 FEET FROM THE WEST LINE OF THE NE/4 OF SECTION 4, T35S, R15E, MONTGOMERY COUNTY, KANSAS. ELEVATION = 879.3'
- COLLINS NO. 1 - 2345 FEET FROM THE SOUTH LINE AND 1060 FEET FROM THE WEST LINE OF THE SE/4 OF SECTION 4, T35S, R15E, MONTGOMERY COUNTY, KANSAS. ELEVATION = 881.3'
- COLLINS NO. 2 - 1830 FEET FROM THE SOUTH LINE AND 1020 FEET FROM THE WEST LINE OF THE SE/4 OF SECTION 4, T35S, R15E, MONTGOMERY COUNTY, KANSAS. ELEVATION = 884.9'

CERTIFICATE OF AUTHORIZATION NO. 2434 EXPIRES 6/30/06

BUCKLAND SURVEYING COMPANY, INC.
LAND SURVEYING SERVICES

1652 S.E. WASHINGTON BLVD.

BARTLESVILLE, OKLAHOMA 74006

(918) 336-6071

RECEIVED
KANSAS CORPORATION COMMISSION

APR 18 2005

CONSERVATION DIVISION
WICHITA, KS