

REQUEST FOR CHANGE OF OPERATOR
TRANSFER OF INJECTION AUTHORIZATION
OR TRANSFER OF SURFACE POND PERMIT

STATE CORPORATION COMMISSION
CONSERVATION DIVISION
200 COLORADO DERBY BLDG.
WICHITA, KS 67202

P09977

DOR 11445
Effective Date of Transfer 1-2-99

Check Applicable Boxes:

Lease Name SHARPE

☒ Oil Lease: No. of Wells 3

SE 1/4 Sec. T 28 S R 9 (W)E

[] Gas Lease: No. of Wells _____

Legal Description of Lease: SE 1/4
Sec. 6 T28 S9 R9 W1E

[] Saltwater Disposal Well - Docket No. _____

Spot Location: _____ feet from N/S Line

_____ feet from E/W Line

County RICE

[] Enhanced Recovery Project Docket No. _____

Entire project: Yes/No

Number of injection wells _____

Production Zone(s) ARB

Injection Zone(s) _____

Field Name Chase - Silica

Surface Pond Permit # ?

330 Feet from N Line of Section

330 Feet from E Line of Section

Identify: Emergency Pit ☒

Burn Pit ☐

Storage Pit ☐

List API#'s on all post-1967 wells transferred with lease: _____

Past Operator's License No. 6166

Contact Person: J.L. Chow INC

Past Operator's Name and Address:

Chew, Bill Inc

516 Sierra

Lyons KS 67554

Phone: 316-257-2327

Date 1-2-99

Title _____

Signature Don Fox

New Operator's License No. 7079

Contact Person DUANE WARD

New Operator's Name and Address

Phone 316-662-2862

Oil/Gas Purchaser NCRA

Date 3-23-99

Title Owner

Signature Don Fox

ACKNOWLEDGEMENT OF TRANSFER: The above request for transfer of injection authorization, surface pond permit # 7079 has been noted, approved and duly recorded in the records of the Kansas Corporation Commission. This acknowledgement of transfer pertains to Kansas Corporation Commission records only and does not convey any ownership interest in the above injection well(s) or pond permit.

_____ is acknowledged
as the new operator and may continue to
inject fluids as authorized by Docket #
_____. Recommended action _____

_____ is acknowledged as the
new operator of the above named lease containing
the surface pond permitted by # _____.

Date _____

Date _____

Authorized Signature

Authorized Signature

EP&F 4/13/05 FROM APR 14 2005 4/13/05

Form T1 10/91

* Lease Name: Sharp * Location: SE/4 5-20-9W

* Location: SE/4 5-20-96

A separate sheet may be attached if necessary

* When transferring a unit which consists of more than one lease please file a separate side two for each lease. If a lease covers more than one section please indicate which section each well is located.

KCC OIL/GAS REGULATORY OFFICE

#05-2-2903

DATE: 3-25-'05

[] New Situation
[X] Response to Request
[] Follow-Up

LOCATION SE, SEC 5, T 20S, R 9WOPERATOR: Fox, DonLICENSE #: 7079ADDRESS: South Main StreetADDRESS: Chase, Ks. 67524LEASE/WELL NUMBER: SharpPHONE #: 620-662-2862COUNTY: RICELEASE INSPECTION: COMPLAINT: FIELD REPORT: X

REASON FOR INVESTIGATION:

Request from Central Office.PROBLEM:

RECEIVED

APR 05 2005

PERSONS CONTACTED:

KCC WICHITA

FINDINGS:


5 wells, 3 producing, 1 new well with pump unit on, but not pumping. 1 aband well.GPS'd wells & tank battery.PHOTOS TAKEN: Yes

ACTION/RECOMMENDATIONS:

To send T.A. NOV letter on Sharp #3.
Turn in field report for further review.

BY

Virgil Clothier
VIRT II

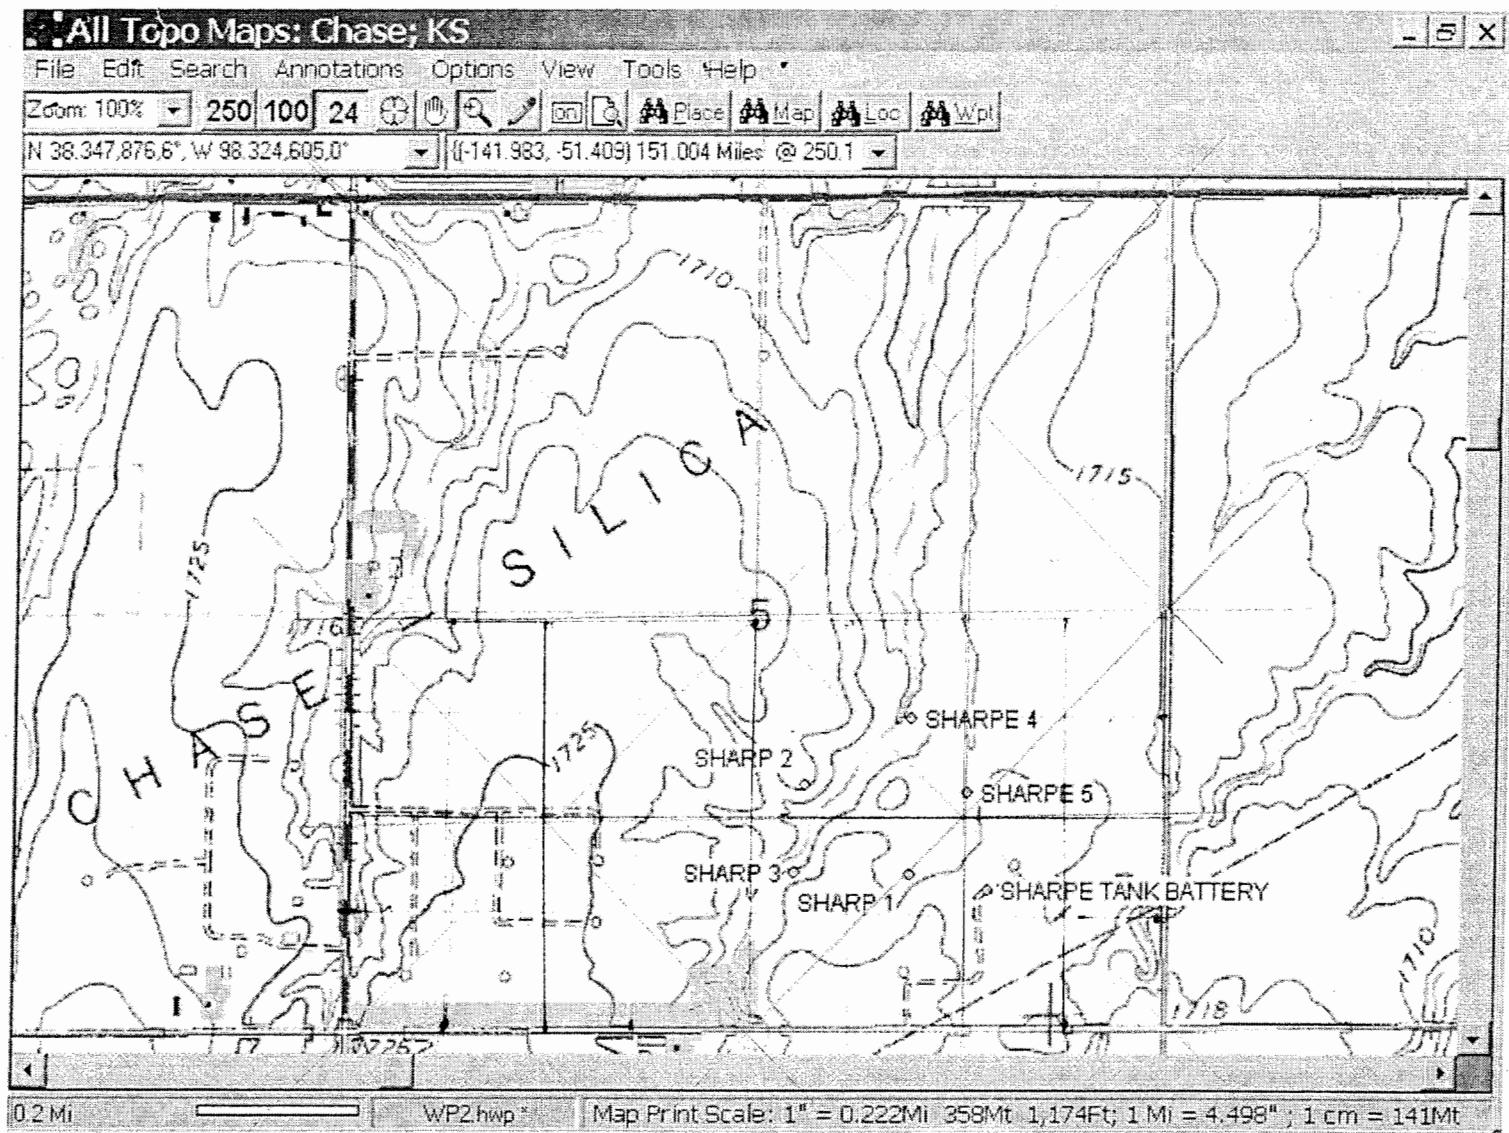

SE-5-20-9W RICE co.

Sharp 1 - producing

Sharp 2 - producing

Sharp 3 - Abandoned - 5 1/2" casing - to send T.A. Nov.

Sharp 4 - producing - new well sp 2002

Sharp 5 - new well - spud 1-11-'05 - pump unit
not running on day of Lse. ck. on
3-25-05.

RECEIVED

APR 05 2005

KCC WICHITA