

KANSAS CORPORATION COMMISSION  
OIL & GAS CONSERVATION DIVISION

REQUEST FOR CHANGE OF OPERATOR  
TRANSFER OF INJECTION OR SURFACE PIT PERMIT

Form T-1  
April 2004  
Form must be Typed  
Form must be Signed  
All blanks must be Filled

Check Applicable Boxes:

☒ Oil Lease: No. of Oil Wells 1 \*\*  
☐ Gas Lease: No. of Gas Wells \_\_\_\_\_ \*\*  
☐ Gas Gathering System: \_\_\_\_\_  
☐ Saltwater Disposal Well - Permit No.: \_\_\_\_\_  
Spot Location: \_\_\_\_\_ feet from ☐ N / ☐ S Line  
\_\_\_\_\_ feet from ☐ E / ☐ W Line  
☐ Enhanced Recovery Project Permit No.: \_\_\_\_\_  
Entire Project: ☐ Yes ☐ No  
Number of Injection Wells \_\_\_\_\_ \*\*  
Field Name: Alford

**\*\* Side Two Must Be Completed.**

Effective Date of Transfer: 10/22/2009  
KS Dept of Revenue Lease No.: 109066 ✓  
Lease Name: Robbins Lease  
\_\_\_\_\_ Sec. 34 Twp. 30 R. 18 ☐ E ☒ W  
Legal Description of Lease: SE/4  
County: Kiowa  
Production Zone(s): Mississippi  
Injection Zone(s): Permian

Surface Pit Permit No.: \_\_\_\_\_  
(API No. if Drill Pit, WO or Haul)

Type of Pit: ☐ Emergency ☐ Burn ☐ Settling ☐ Haul-Off ☐ Workover ☐ Drilling

Past Operator's License No. 5363 ✓  
Past Operator's Name & Address: BEREXCO INC.  
PO Box 20380, Wichita KS 67208-1380  
Title: Mgr of Prod Admin

Contact Person: Emma Richmond  
Phone: 316-337-8370  
Date: 4/12/10  
Signature: Emma Richmond

New Operator's License No. 34318 ✓  
New Operator's Name & Address: Berexco LLC  
PO Box 20380  
Wichita, KS 67208-1380  
Title: Mgr of Prod Admin

Contact Person: Emma Richmond  
Phone: 316-337-8370  
Oil / Gas Purchaser: Central Crude Corporation  
Date: 4/12/10  
Signature: Emma Richmond

**Acknowledgment of Transfer:** The above request for transfer of injection authorization, surface pit permit # \_\_\_\_\_ has been noted, approved and duly recorded in the records of the Kansas Corporation Commission. This acknowledgment of transfer pertains to Kansas Corporation Commission records only and does not convey any ownership interest in the above injection well(s) or pit permit.

\_\_\_\_\_ is acknowledged as the  
new operator and may continue to inject fluids as authorized by  
Permit No.: \_\_\_\_\_. Recommended action: \_\_\_\_\_  
Date: \_\_\_\_\_

\_\_\_\_\_ is acknowledged as the  
new operator of the above named lease containing the surface pit  
permitted by No.: \_\_\_\_\_.  
Date: \_\_\_\_\_

Authorized Signature \_\_\_\_\_  
DISTRICT \_\_\_\_\_ EPR 4-15-10 PRODUCTION 4/15/10 UIC 4-15-10  
Mail to: Past Operator \_\_\_\_\_ New Operator \_\_\_\_\_ District \_\_\_\_\_  
RECEIVED  
APR 13 2010

Mail to: KCC - Conservation Division, 130 S. Market - Room 2078, Wichita, Kansas 67202

KCC WICHITA


102209\_Robbins\_Lease.pdf



CONSERVATION DIVISION  
500 INSURANCE BLDG.  
212 NORTH MARKET  
WICHITA 2, KANSAS

No. Address  
P. O. Box 17027  
Wichita, Ka. 67217

County \_\_\_\_\_ Range \_\_\_\_\_ County Kiowa & Comanche Pool Alford

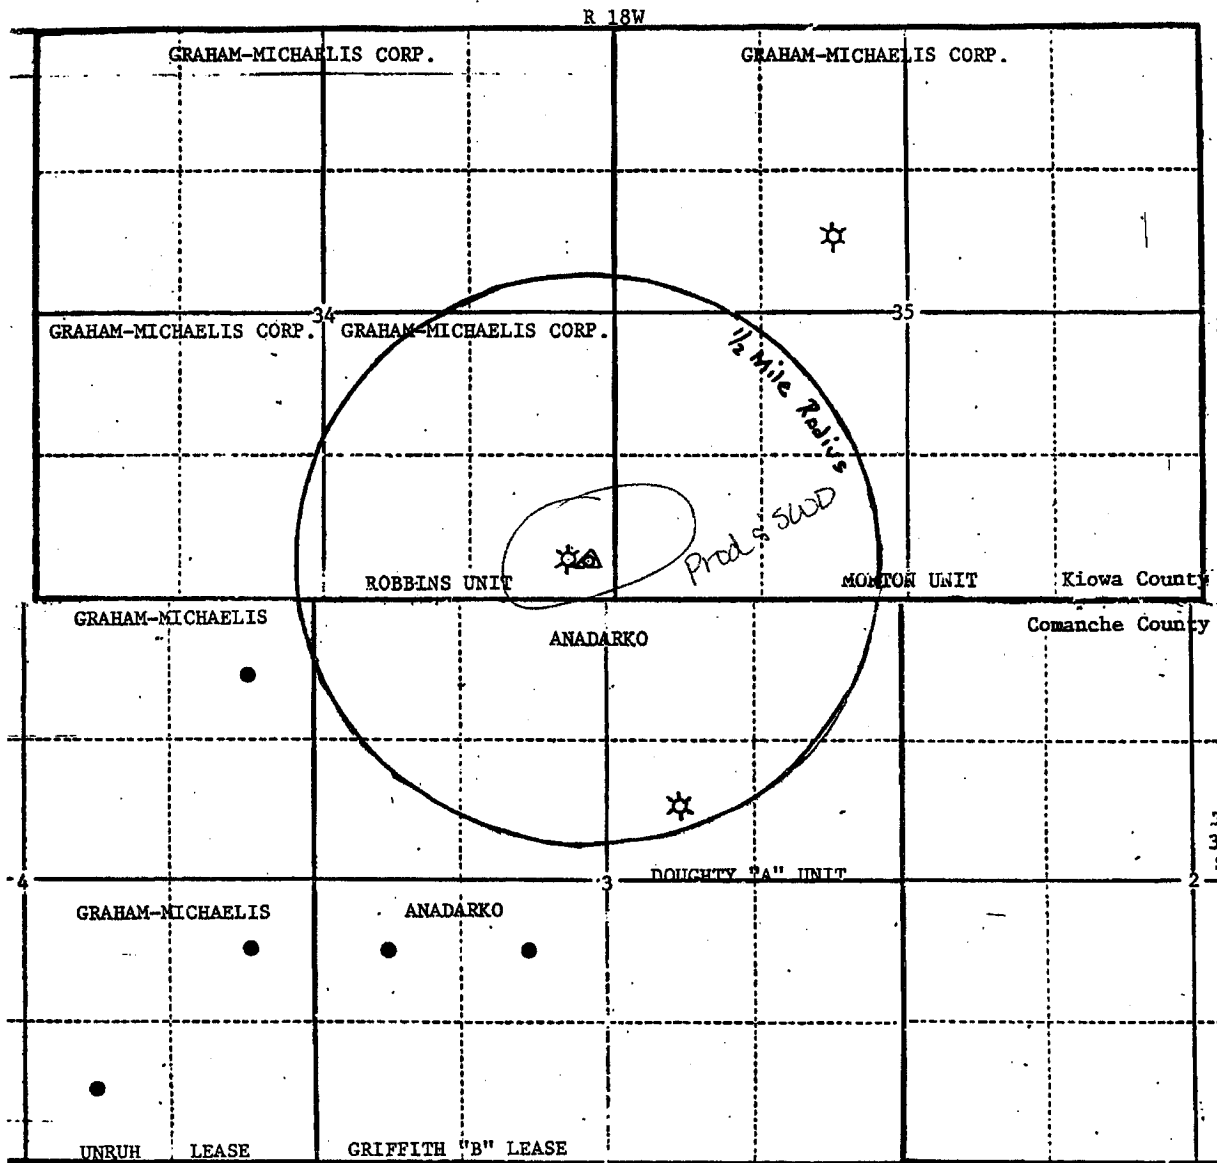

Scale: 1" = 1320'

STATE OF KANSAS,  
COUNTY OF SEDGWICK

I, Jack L. Yinger  
of Graham-Michaelis Corporation, do hereby certify  
that the above locations, feet measurements and areas are true and correct to the best of my knowledge.

Subscribed and sworn to before me this 19th day of November, 1973

My commission expires \_\_\_\_\_

MURIEL F. C. JERAM  
NOTARY PUBLIC  
SEDGWICK COUNTY, KANSAS  
MY COMMISSION EXPIRES  
JULY 25, 1976

Muriel F. C. Jeram  
NOTARY PUBLIC