080112_Briggs.pd

Kansas Corporation Commission Oil & Gas Conservation Division

Form T-1 March 2010 Form must be Typed Form must be Signed All blanks must be Filled

REQUEST FOR CHANGE OF OPERATOR TRANSFER OF INJECTION OR SURFACE PIT PERMIT

Form KSONA-1, Certification of Compliance with the Kansas Surface Owner Notification Act,
MUST be submitted with this form

Check Applicable Boxes:	niueg with this form.
Oil Lease: No. of Oil Wells**	Effective Date of Transfer: 08/01/2012
Gas Lease: No. of Gas Wells**	KS Dept of Revenue Lease No.: 142811
Gas Gathering System:	Lease Name: Briggs
Saltwater Disposal Well - Permit No.:	N2.52.5€. SW _{Sec. 35} Twp. 13 R. 29 ☐ E ✓ W
Spot Location: 460 feet from N / ✓ S Line	· · · · · · · · · · · · · · · · · · ·
1980 feet from ☐ E / ✓ W Line	Legal Description of Lease: Section 35-T13S-R29W
Enhanced Recovery Project Permit No.:	RECEIVED
Entire Project: Yes No	County: Gove SEP 1 4 2012
Number of Injection Wells **	Production Zone(s): Open Hole
Field Name: Hoffsmith	KCC WICHITA
** Side Two Must Be Completed.	Injection Zone(s): NA NOO VIOLITA
Surface Pit Permit No.: 15-063-21976-00-00	460
(API No. if Drill Pit, WO or Haul)	1980 feet from ☐ E / ✔ W Line of Section
Type of Pit: Emergency Burn Settling	Haul-Off Workover Drilling
Past Operator's License No. 34658 /	Contact Person: Bob Ed Culver, Jr.
Past Operator's Name & Address:Arrington CJM, Inc.	Phone: 806-323-5366
PO Box 608, Canadian, TX 79014	Date: 08/23/2012
Title: President	Signature: Bol Blulver,
New Operator's License No. 34729 /	Contact Person: Ed Birdwell
New Operator's Name & Address: Sanchez 011 & Gas Corp.	
1111 Bagby St., Ste. 1800	Oil / Gas Purchaser: Coffeyville Resources
Houston, Tx. 77002	Date: 09/12/12
Title: Vice President	Signature:
A classical amount of Transfers. The characteristics for transfer of injection	n authorization, surface pit permit # 15-063-21976-00-00 has been
Acknowledgment of Transfer: The above request for transfer of injection	n Commission. This acknowledgment of transfer pertains to Kansas Corporation
noted, approved and duly recorded in the records of the Kansas Corporation Commission records only and does not convey any ownership interest in the	
Commission records only and does not convey any ownership interest in the	ABOTO INJUSTICE TORIO, OF PR POTTING
is acknowledged as	Sancher Dil+Gas Corp. is acknowledged as
the new operator and may continue to inject fluids as authorized by	the new operator of the above named lease containing the surface pit
Permit No.: Recommended action:	permitted by No.: 15-063-21976-00-00.
. Neconinended action.	portinition by Production
Poto	Date: 9/25/12 Olivia Raisses
Date:	Authorized Signature C.C. Ka
DISTRICT EPR 9/25/12	PRODUCTION 9.26.12 UIC 9-26-12
Mail to: Past Operator New Opera	

Side Two

Must Be Filed For All Wells

KDOR Lease No.:	142811	

* Lease Name:	Briggs	· · · · · · · · · · · · · · · · · · ·	* Location:S	Section 35-T13S-R29W	
Well No.	API No. (YR DRLD/PRE '67)	Footage from (i.e. FSL = Feet fr	Section Line om South Line)	Type of Well (Oil/Gas/INJ/WSW)	Well Status (PROD/TA'D/Abandoned)
1-35	15-063-21976	460 Circle	1980 Circle	oil	TA
		FSL/FNL	FEL/FWL		
		FSL/FNL	FEL/FWL		
		FSL/FNL	FEL/FWL		
		FSL/FNL	FEL/FWL	-	
		FSL/FNL	FEL/FWL		***************************************
		FSL/FNL	FEL/FWL	1444	
		FSL/FNL	FEL/FWL		•
		FSL/FNL	FEL/FWL		
		FSL/FNL	FEL/FWL		
		FSL/FNL	FEL/FWL	- , , , , , , , , , , , , , , , , , , ,	
		FSL/FNL	FEL/FWL		
		FSL/FNL	FEL/FWL		
		FSL/FNL	FEL/FWL		RECEIVED
		FSL/FNL	FEL/FWL		SEP 1 4 2012
		FSL/FNL	FEL/FWL		KCC WICHITA
		FSL/FNL	FEL/FWL		,

A separate sheet may be attached if necessary

^{*} When transferring a unit which consists of more than one lease please file a separate side two for each lease. If a lease covers more than one section please indicate which section each well is located.

KANSAS CORPORATION COMMISSI OIL & GAS CONSERVATION DIVISION

1075881

Form KSONA-1 July 2010 Form Must Be Typed Form must be Signed All blanks must be Filled


CERTIFICATION OF COMPLIANCE WITH THE KANSAS SURFACE OWNER NOTIFICATION ACT

This form must be submitted with all Forms C-1 (Notice of Intent to Drill); CB-1 (Cathodic Protection Borehole Intent); T-1 (Request for Change of Operator Transfer of Injection or Surface Pit Permit); and CP-1 (Well Plugging Application).

Any such form submitted without an accompanying Form KSONA-1 will be returned.

OPERATOR: License # 34658	Well Location:		
Name: Arrington CJM, Inc.	N2 S2 SE SW 3 35 _ 13 20 -		
Address 1: 300 Houston Ave.	N2 S2 SE SW Sec. 35 Twp. 13 S. R. 29 Eas X Wes		
Address 2: PO BOX 608	County: Gove Lease Name: Briggs Well #: 1-35		
City: CANADIAN State: TX 79014	Well #: 1-00		
Contact Person: Ed Culver	If filing a Form T-1 for multiple wells on a lease, enter the legal description of the lease below:		
Phone: (806) 323-5366 Fax: (806) 323-5369	RECEIVED		
OPERATOR: License # 34658 Name; Arrington CJM, Inc. Address 1: 300 Houston Ave. Address 2: PO BOX 608 City: CANADIAN State: TX Zip: 79014 + Contact Person: Ed Culver Phone: (806) 323-5366 Fax: (806) 323-5369 Email Address: cjm-ed@att.net	SEP 2 4 2012		
Surface Owner Information:	KCC WICHITA		
Name: Bill Briggs	-		
Name: Bill Briggs Address 1: 810 County Road 50 Address 2:	sheet listing all of the information to the left for each surface owner. Surface		
Address 2:	owner information can be found in the records of the register of deeds for the county, and in the real estate property tax records of the county treasurer.		
City: Gove State: KS Zip: 67736 +	<u> </u>		
are preliminary non-binding estimates. The locations may be entered	hodic Protection Borehole Intent), you must supply the surface owners and ank batteries, pipelines, and electrical lines. The locations shown on the plat I on the Form C-1 plat, Form CB-1 plat, or a separate plat may be submitted.		
are preliminary non-binding estimates. The locations may be entered Select one of the following: I certify that, pursuant to the Kansas Surface Owner Notice	Ink batteries, pipelines, and electrical lines. The locations shown on the plat on the Form C-1 plat, Form CB-1 plat, or a separate plat may be submitted. Act (House Bill 2032) I have provided the following to the surface		
Select one of the following: I certify that, pursuant to the Kansas Surface Owner Notice owner(s) of the land upon which the subject well is or will be	Act (House Bill 2032), I have provided the following to the surface clocated: 1) a copy of the Form C-1, Form CB-1, the plate of the surface clocated: 1) a copy of the Form C-1, Form CB-1, Form T-1, or Form to being filed is a Form C-1 or Form CB-1, the plate of the surface clocated: 1) a copy of the Form C-1, Form CB-1, Form T-1, or Form to being filed is a Form C-1 or Form CB-1, the plate of the surface clocated: 1) a copy of the Form C-1, or will be CP-1 that I am filing in connection with this form; 2) if the form form; and 3) my operator name, address, phone number, fax, I have not provided this information to the surface owner(s).	Act (House Bill 2032), I have provided the following to the surface clocated: 1) a copy of the Form C-1, Form CB-1, the plat(s) required by this and email address. acknowledge that, because I have not provided this information, the powner(s). To mitigate the additional cost of the KCC performing this		




Mail to: KCC - Conservation Division. 130 S. Market - Room 2078. Wichita. Kansas 67202

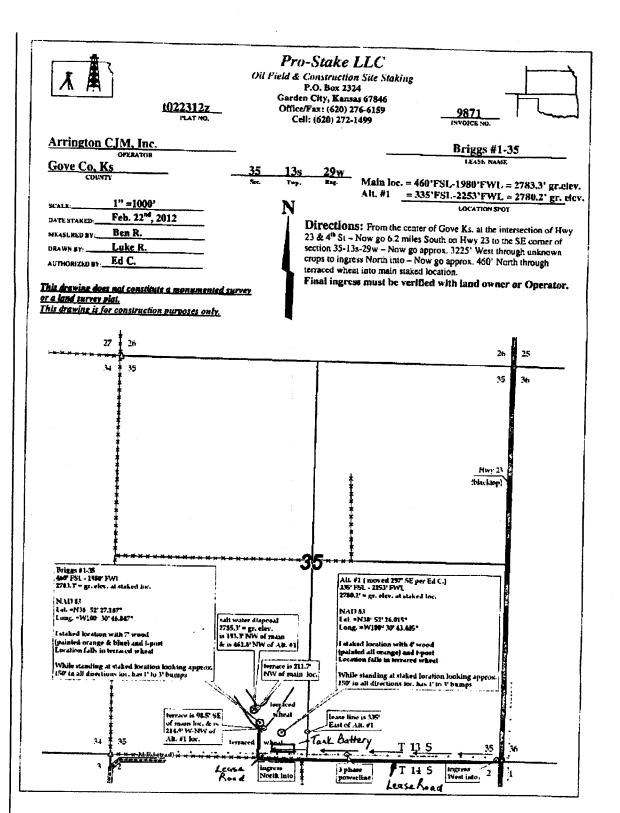

RECEIVED SEP 2 4 2012 KCC WICHITA