KANSAS CORPORATION COMMISSION OIL & GAS CONSERVATION DIVISION

Form T-1 July 2014 Form must be Typed Form must be Signed All blanks must be Filled

REQUEST FOR CHANGE OF OPERATOR TRANSFER OF INJECTION OR SURFACE PIT PERMIT Form KSONA-1, Certification of Compliance with the Kansas Surface Owner Notification Act,

MUST be submitted with this form. Check Applicable Boxes: ✓ Oil Lease: No. of Oil Wells 07/20/2016 Effective Date of Transfer: Gas Lease: No. of Gas Wells KS Dept of Revenue Lease No.: 120694 Gas Gathering System: Lease Name: Venamon Saltwater Disposal Well - Permit No.: _ Sec. 5 Twp. 35 feet from N / S Line SW4,S2SE4,S2NW4SE4,S2NE4SE4 Legal Description of Lease: feet from | E / W Line Lots 1,3,4,5,6, W2 of Lot 7 Sec 5-35S-12E Enhanced Recovery Project Permit No.: Entire Project: ✓ Yes No County: Chautauqua Number of Injection Wells Production Zone(s): Wayside Field Name: Peru-Sedan Wayside Injection Zone(s): ** Side Two Must Be Completed. Surface Pit Permit No.: S Line of Section (API No. if Drill Pit, WO or Haul) W Line of Section Type of Pit: Emergency Burn Settling Haul-Off Workover Drilling 5451 Dale Fadely Past Operator's License No. Contact Person: Dale Leon Fadely Past Operator's Name & Address: 620-249-0287 Phone: 909 Hwy 99 Sedan, KS 67361 Tille: operator L. Fadely KCC WICHITA 34680 🗸 Tim Doty New Operator's License No. Contact Person: JUL 2 1 2016 Phone: 620-331-9791 TDOT Oil, Inc. New Operator's Name & Address: P.O. Box 117 Sedan, KS 67361 Oil / Gas Purchaser: Coffeyville Resources Date: Title: President Signature: Acknowledgment of Transfer: The above request for transfer of injection authorization, surface pit permit # noted, approved and duly recorded in the records of the Kansas Corporation Commission. This acknowledgment of transfer pertains to Kansas Corporation Commission records only and does not convey any ownership interest in the above injection well(s) or pit permit, __ is acknowledged as the new operator and may continue to inject fluids as authorized by the new operator of the above named lease containing the surface pit . Recommended action: permitted by No.: Date: Authorized Signature Authorized Signature DISTRICT PRODUCTION Mail to: Past Operator New Operator District 3

Side Two

Must Be Filed For All Wells

KDOR Lease	No.: 120694				
* Lease Name: _	Venamon	The second secon	* Location:	Sec 5-35S-12E	Platt map attached
Well No.	API No. (YR DRLD/PRE '67)	Footage from (i.e. FSL = Feet fr		Type of Well (Oil/Gas/INJ/WSW	. Well Status /) (PROD/TA'D/Abandoned)
120-1	15-019-23434 🗸	1882 FSL FNL	1163 Circle FEL/FWL	Oil	Prod
2	15-019-19911	1541 FSL/FNL	2656 FEI/FWL	Oil	Prod
3	15-019-21180	1345 FSL/FNL	2986 FEIJFWL	Oil	Prod
C4	15-019-19816	2827 FSUFNL	2918 FEI/FWL	Oil	Prod
C5	15-019-19817	2844 FSUFNL	2509 FEDFWL	Oil	Prod
TA1	15-019-26612 🗸	1552 FSJ FNL	2116 FELFWL	Oil	Prod
TA2	15-019-26645	1680 FSUFNL	1703 FEDFWL	Oil	Prod
4	15-019-21306-00-02	764 FSUFNL	3223 FELFWL	INJ	Active
		FSL/FNL	FEL/FWL	-	
		FSL/FNL	FEL/FWL		
		FSL/FNL	FEL/FWL		
		FSL/FNL	FEL/FWL	8- 12-12-13-14-14-14-14-14-14-14-14-14-14-14-14-14-	
		FSL/FNL	FEL/FWL		
		FSL/FNL	FEL/FWL	·	
		FSL/FNL	FEL/FWL		
		FSL/FNL	FEL/FWL		
		FSL/FNL	FEL/FWL		
		FSL/FNL	FEL/FWL		
		FSL/FNL	FEL/FWL		
		FSL/FNL	FEL/FWL		MICHITA
		FSL/FNL	FEL/FWL	K	JUL 2 1 2016
		FSL/FNL	FEL/FWL		RECEIVED
		FSL/FNL	FEL/FWL		1 30
		FSL/FNL	FEL/FWL .		

A separate sheet may be attached if necessary

^{*} When transferring a unit which consists of more than one lease please file a separate side two for each lease. If a lease covers more than one section please indicate which section each well is located.

KANSAS CORPORATION COMMISSION OIL & GAS CONSERVATION DIVISION

Form KSONA-1 July 2014 Form Must Be Typed Form must be Signed All blanks must be Filled


RECEIVED

CERTIFICATION OF COMPLIANCE WITH THE KANSAS SURFACE OWNER NOTIFICATION ACT

This form must be submitted with all Forms C-1 (Notice of Intent to Drill); CB-1 (Cathodic Protection Borehole Intent); T-1 (Request for Change of Operator Transfer of Injection or Surface Pit Permit); and CP-1 (Well Plugging Application).

Any such form submitted without an accompanying Form KSONA-1 will be returned.

Contact Person: Tim Doty Phone: (620) 331-9791	04000			
Address 1: P.O. Box 117 Address 2: Lease Name: Venamon Well #: Contact Person: Tim Doty the lease below: SW4, S2SE4,S2NW4SE4,S2NE4SE4, Lots 1,3,4,5,6, W2 of Lot 7 Sec 5-35S-12E Surface Owner Information: Name: Paul M. Venamon Rev Tr When filing a Form T-1 involving multiple surface owners, surface owner information to the left for each surface owners. Surface owner information and in the records of the register of deeds for the county, and in the real estate property tax records of the county treasurer. If this form is being submitted with a Form C-1 (Intent) or CB-1 (Cathodic Protection Borehole Intent), you must supply the surface owners and the KCC with a plat showing the predicted locations of lease roads, tank batteries, pipelines, and electrical lines. The locations shown on the plat are preliminary non-binding estimates. The locations may be entered on the Form C-1 plat, Form CB-1 plat, or a separate plat may be submitted. Select one of the following: I certify that, pursuant to the Kansas Surface Owner Notice Act (House Bill 2032), I have provided the following to the surface owner(s) of the land upon which the subject well: so or will be located: 1) a copy of the Form C-1, Form CB-1, Form T-1, or Form CP-1 that 1 am filing in connection with this form; 2 if the form being filed is a Form C-1 or Form CB-1, the plat(s) required by this form, and 3) my operator name, address, phone number, [ax, and email address.] I have not provided this information to the surface owner(s). I acknowledge that, because I have not provided this information to the surface owner(s). To mitigate the additional cost of the KCC performing this task, I acknowledge that I must provide the name and address of the surface owner by filling out the top section of this form. the KCO with the second option, submit payment of the \$30.00 handling fee with this form. If the fee is not received with this				
Address 2: City. Sedan State: KS Zip: 67361 +	Name: IDOT Oil, Inc.			
Contact Person; Tim Doty Contact Person; Tim Doty Contact Person; Tim Doty State; KS Zip; 67361 +	Address 1: P.O. Box 117			
Contact Person: Tim Doty Phone: (620) 331-9791 Fax: ()		Lease Name: Venamon Well #:		
Contact Person: 1997 Phone: (620) 331-9791 Email Address: Idotoil@yahoo.com SW4, \$2SE4,\$2NW4SE4,\$2NE4SE4, Lots 1,3,4,5,6, W2 of Lot 7 Sec 5-35S-12E Surface Owner Information: Name: Paul M. Venamon Rev Tr Address 1: P.O. Box 1093 Address 2:		If filing a Form T-1 for multiple wells on a lease, enter the legal description of		






Date: 7-20-16 Signature of Operator or Agent: 5-65 Title: operator Title: CC WICHITA	hereby certify that the statements made herein are true and correct to			
2 4 2016	Date: 7-20-16 Signature of Operator or Agent:	operator Title:KCC WICHITA		
		2016		

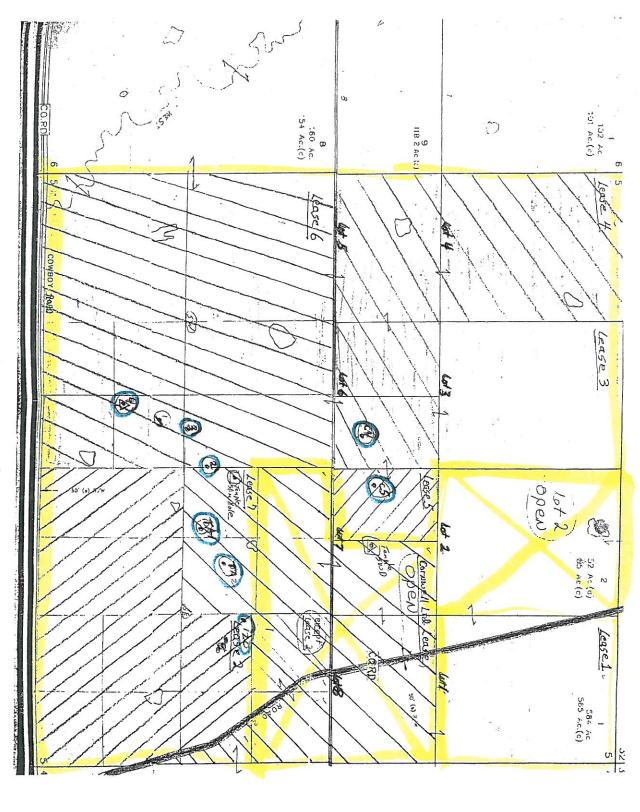

Venamon Lease

That Oil, Inc