

CORRECTED 3/19/2017
MWA-CHC

110116_Gropp_1.pdf

KANSAS CORPORATION COMMISSION
OIL & GAS CONSERVATION DIVISION

Form T-1
July 2014
Form must be Typed
Form must be Signed
All blanks must be Filled

**REQUEST FOR CHANGE OF OPERATOR
TRANSFER OF INJECTION OR SURFACE PIT PERMIT**

Form KSONA-1, Certification of Compliance with the Kansas Surface Owner Notification Act,
MUST be submitted with this form.

Check Applicable Boxes:

- ☐ Oil Lease: No. of Oil Wells _____ **
- ☒ Gas Lease: No. of Gas Wells 1 **
- ☐ Gas Gathering System: _____
- ☐ Saltwater Disposal Well - Permit No.: _____
- Spot Location: _____ feet from ☐ N / ☐ S Line
_____ feet from ☐ E / ☐ W Line
- ☐ Enhanced Recovery Project Permit No.: _____
- Entire Project: ☐ Yes ☐ No
- Number of Injection Wells _____ **

Field Name: HUGOTON

**** Side Two Must Be Completed.**

Effective Date of Transfer: NOVEMBER 1, 2016

KS Dept of Revenue Lease No.: 201402 *✓*

Lease Name: GROPP 1

NE - NE - NW - SE Sec. 18 Twp. 23S R. 37 ☐ E ☒ W

Legal Description of Lease: 2540 FSL & 1390 FEL

"See Attachment 1"

County: KEARNY

Production Zone(s): CHASE

Injection Zone(s): _____

Surface Pit Permit No.: _____
(API No. if Drill Pit, WO or Haul)

Type of Pit: ☐ Emergency ☐ Burn ☐ Settling ☐ Haul-Off ☐ Workover ☐ Drilling

Past Operator's License No. 5249 *✓*

Past Operator's Name & Address: OSBORN HEIRS COMPANY, LTD
P.O. Box 17968, San Antonio, Texas 78217

Title: Vice-President

Contact Person: Nancy FitzSimon

Phone: (210) 826-0700

Date: October 31, 2016

Signature: Nancy A. FitzSimon

KCC WICHITA

NOV 28 2016

RECEIVED

New Operator's License No. 34832 *✓*

New Operator's Name & Address: SCOUT ENERGY MANAGEMENT LLC
4901 LBJ FREEWAY, STE. 300, DALLAS, TEXAS 75244

JON PIOT

Title: MANAGING DIRECTOR /Sr. Regulatory Specialist

Contact Person: KIM BRAND, SR. REGULATORY SPECIALIST

Phone: (972) 865-7597

Oil / Gas Purchaser: "See Attachment 1"

Date: OCTOBER 31, 2016

Signature: K Brand

Acknowledgment of Transfer: The above request for transfer of injection authorization, surface pit permit # _____ has been noted, approved and duly recorded in the records of the Kansas Corporation Commission. This acknowledgment of transfer pertains to Kansas Corporation Commission records only and does not convey any ownership interest in the above injection well(s) or pit permit.

_____ is acknowledged as
the new operator and may continue to inject fluids as authorized by
Permit No.: _____. Recommended action: _____

Date: _____
Authorized Signature

_____ is acknowledged as
the new operator of the above named lease containing the surface pit
permitted by No.: _____

Date: _____
Authorized Signature

DISTRICT _____ EPR 4/6/17 PRODUCTION APR 07 2017 APR 07 2017
Mail to: Past Operator _____ New Operator _____ District _____

KCC - Conservation Division, 266 N Main St, Ste 220, Wichita, KS 67202-1513

SCANNED

SCANNED

KANSAS CORPORATION COMMISSION
OIL & GAS CONSERVATION DIVISION

Form KSONA-1
July 2010
Form Must Be Typed
Form must be Signed
All blanks must be Filled

**CERTIFICATION OF COMPLIANCE WITH THE
KANSAS SURFACE OWNER NOTIFICATION ACT**

*This form must be submitted with all Forms C-1 (Notice of Intent to Drill); CB-1 (Cathodic Protection Borehole Intent);
T-1 (Request for Change of Operator Transfer of Injection or Surface Pit Permit); and CP-1 (Well Plugging Application).
Any such form submitted without an accompanying Form KSONA-1 will be returned.*

Select the corresponding form being filed: ☐ C-1 (Intent) ☐ CB-1 (Cathodic Protection Borehole Intent) ☒ T-1 (Transfer) ☐ CP-1 (Plugging Application)

OPERATOR: License # 5249
Name: OSBORN HEIRS COMPANY, LTD.
Address 1: P.O. BOX 17968
Address 2: _____
City: SAN ANTONIO State: TX Zip: 78217 + 0968
Contact Person: MARI CASTORENO
Phone: (210) 826-0700 Fax: (210) 826-7559
Email Address: maric@osbornheirs.com

Well Location:
NE NE NW SE Sec. 18 Twp. 23 S. R. 37 ☐ East ☒ West
County: KEARNY
Lease Name: GROPP Well #: 1

If filing a Form T-1 for multiple wells on a lease, enter the legal description of the lease below:

GROUP 1A C SE SEC. 18-23S-37W

KCC WICHITA
NOV 28 2016
RECEIVED

Surface Owner Information:

Name: CLETUS PLOEGER FAMILY TST
Address 1: P.O. BOX 67
Address 2: _____
City: LAKIN State: KS Zip: 67860 + _____

When filing a Form T-1 involving multiple surface owners, attach an additional sheet listing all of the information to the left for each surface owner. Surface owner information can be found in the records of the register of deeds for the county, and in the real estate property tax records of the county treasurer.

If this form is being submitted with a Form C-1 (Intent) or CB-1 (Cathodic Protection Borehole Intent), you must supply the surface owners and the KCC with a plat showing the predicted locations of lease roads, tank batteries, pipelines, and electrical lines. The locations shown on the plat are preliminary non-binding estimates. The locations may be entered on the Form C-1 plat, Form CB-1 plat, or a separate plat may be submitted.

Select one of the following:

☒ I certify that, pursuant to the Kansas Surface Owner Notice Act (House Bill 2032), I have provided the following to the surface owner(s) of the land upon which the subject well is or will be located: 1) a copy of the Form C-1, Form CB-1, Form T-1, or Form CP-1 that I am filing in connection with this form; 2) if the form being filed is a Form C-1 or Form CB-1, the plat(s) required by this form; and 3) my operator name, address, phone number, fax, and email address.

☐ I have not provided this information to the surface owner(s). I acknowledge that, because I have not provided this information, the KCC will be required to send this information to the surface owner(s). To mitigate the additional cost of the KCC performing this task, I acknowledge that I am being charged a \$30.00 handling fee, payable to the KCC, which is enclosed with this form.

If choosing the second option, submit payment of the \$30.00 handling fee with this form. If the fee is not received with this form, the KSONA-1 form and the associated Form C-1, Form CB-1, Form T-1, or Form CP-1 will be returned.

I hereby certify that the statements made herein are true and correct to the best of my knowledge and belief.

Date: 10/31/16 Signature of Operator or Agent: Nancy A. FitzSimons Title: VICE-PRESIDENT

Received
KANSAS CORPORATION COMMISSION

MAR 13 2017

CONSERVATION DIVISION
WICHITA, KS

ATTACHMENT I

Form T-1

Well: Gropp 1

County: Kearny

API: 15-093-00167

Legal Description of Unit: N/2 & SE/4 Sec 18-23S-37W & SE/4 Sec 13-23S-38W

Oil/Gas Purchaser: Energy Transfer Partners, LP

Leases Included*:

LESSOR	LESSEE	LEASE DATE	EFFECT. DATE	VOL	PAGE	LEGAL DESCRIPTION
Gropp, Geo., Et Ux	Parks, S.L.	2/13/1952	2/13/1952	21	486	T-23-S, R-37-W SECTION 18: SE/4 KEARNY COUNTY, KANSAS
Tickell, Irene, a Single Woman	Parks, S.L.	4/16/1952	4/16/1952	22	451	T-23-S, R-37-W SECTION 18: LOTS 1 & 2; E/2 NW/4 (153.04 ACRES) KEARNY COUNTY, KANSAS
Morris, R. G.	MCCORMICK, P. S.	5/6/1946	5/6/1946	14	166	T-23S, R-38W INSOFAR AS SAID LEASE COVERS: SECTION 13: N/2 SE/4, AS TO THOSE DEPTHS ABOVE SEA LEVEL; S/2 SE/4, ALL DEPTHS KEARNY COUNTY, KANSAS
Milford, Frances	MCCORMICK, P. S.	5/6/1946	5/6/1946	14	165	T-23S, R-38W INSOFAR AS SAID LEASE COVERS: SECTION 13: N/2 SE/4, AS TO THOSE DEPTHS ABOVE SEA LEVEL; S/2 SE/4, ALL DEPTHS KEARNY COUNTY, KANSAS
Stites, Julia F.	Rock Island Oil & Refining Co., Inc.	2/27/1954	2/27/1954	25	210	T-23S, R-37W SECTION 18: NE/4 KEARNY COUNTY, KANSAS

*Insofar as to rights conveyed from surface to 100 feet below the Council Grove.

KCC WICHITA
MAR 24 2017
RECEIVED

KCC WICHITA
NOV 28 2016
RECEIVED

Received
KANSAS CORPORATION COMMISSION

MAR 13 2017
CONSERVATION DIVISION
WICHITA, KS

Gropp Unit No I

T 23 S

R 37 W

Location staked in the SE ²
 $\frac{1}{4}$ of Sec 18. 1250' East of
 west line & 100' South of
 the north line.
 Kearny County, State of
 Kansas.

I, J E Myler under bond and a registered Civil Engineer do hereby swear this is a correct measure to locate --drilling site for Gas well location as Instructed by--
Intrested Parties.


Seal

J E Myler - Lakin Kansas.

JE Miller - 12/11/1910

KCC WICHITA
MAR 24 2017
RECEIVED

EXHIBIT A

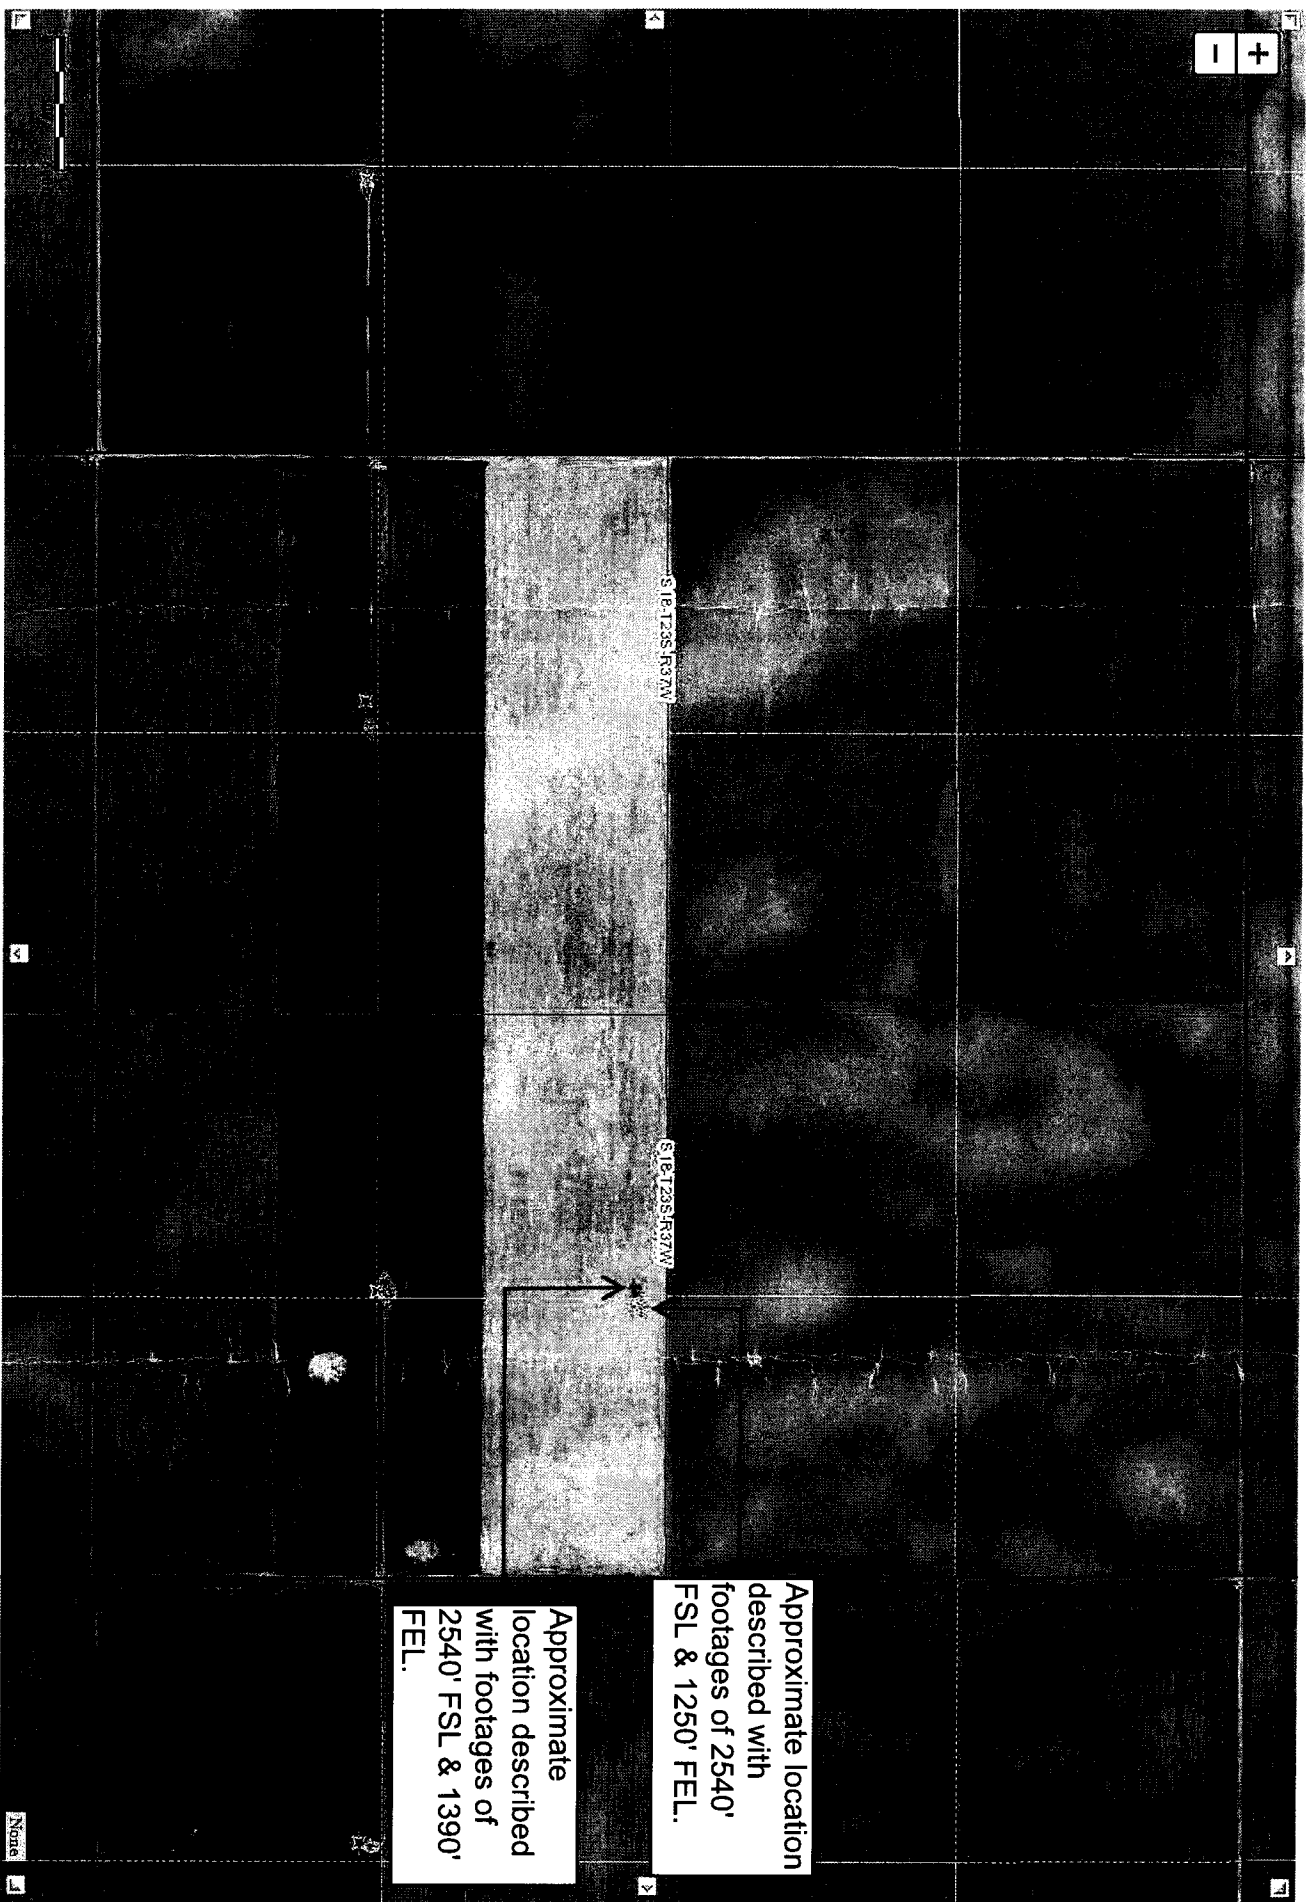

Approximate location described with footages of 2540' FSL & 1250' FEL.

Approximate location described with footages of 2540' FSL & 1390' FEL.