

REQUEST FOR CHANGE OF OPERATOR
TRANSFER OF INJECTION AUTHORIZATION
OR TRANSFER OF SURFACE POND PERMIT

KANSAS CORPORATION COMMISSION
CONSERVATION DIVISION
130 S MARKET, ROOM 2078
WICHITA, KANSAS 67202

Check Applicable Boxes:

[X] Oil Lease: No. of Wells 5 **

[] Gas Lease: No. of Wells _____ **

** SIDE TWO MUST BE COMPLETED **

[X] Saltwater Disposal Well - Docket No. EM516
Spot Location: 660 feet from N/S Line
3300 feet from E/W Line

[] Enhanced Recovery Proj. Docket No. _____

Entire project: Yes/No

Number of injection wells _____ **

Field Name Harper Ranch

Surface Pond Permit # _____
(API No. If Drill Pit)

Identify: Emergency Pit ☐

Burn Pit ☐

Storage Pit ☐

Drill Pit ☐

Past Operator's License No. 31540 ^{Exp 10/30/95}

Past Operator's Name and Address:

Americase Prod
110 Gwendola
McKinney TX 75090

Title _____

New Operator's License No. 03688

New Operator's Name and Address

4-D Petroleum Consultants, LLC
424 Saratoga Ct.
Pratt, KS 67124-3119

Title Owner/Manager

Effective Date of Transfer 02/26/98

Lease Name Harper Ranch

- ALL Sec 2311 T 34S R 21 W/E

Legal Description of Lease: _____

County Clarke

Production Zone(s) Morrison

Injection Zone(s) Morrison

Feet from N/S Line of Section
Feet from E/W Line of Section

None to my knowledge

Contact Person: STAN CASE

Phone: 972-562-0735

Date July 5, 1998

Signature Stan Case

Contact Person Richard Armer

Phone 316-672-3157

Oil/Gas Purchaser NCRA

Date 8-19-98

Signature Richard Armer

ACKNOWLEDGEMENT OF TRANSFER: The above request for transfer of injection authorization, surface pond permit # _____ has been noted, approved and duly recorded in the records of the Kansas Corporation Commission. This acknowledgement of transfer pertains to Kansas Corporation Commission records only and does not convey any ownership interest in the above injection well(s) or pond permit.

_____ is acknowledged as the new operator and may continue to inject fluids as authorized by Docket # _____. Recommended action _____

Date _____
Authorized Signature _____

_____ is acknowledged as the new operator of the above named lease containing the surface pond permitted by # _____

Date _____
Authorized Signature _____

MUST BE FILED FOR ALL WELLS

*LEASE NAME

Harper Ranch

*LOCATION:

Sec. 2 T11-34S-21W

WELL NO.

API NO.

(YR DRLD/PRE '67)

FOOTAGE FROM SECTION LINE

(i.e. FSL=Feet from South Line)

TYPE OF WELL
(OIL/GAS
INJ/WSW)


WELL STATUS
(PROD/TA'D
ABANDONED)

KC #4	SEC 11	15-025-10109 C NW NE	4620	Circle FSL/FNL	1980	Circle FEL/FWL	Oil	Prod.
JC #4	SEC 2	15-025-10150 C SW SW	660	FSL/FNL	660	FEL/FWL	Oil	Prod
JC #5	SEC. 2	15-025-10100 C NW SW	1980	FSL/FNL	660	FEL/FWL	"	"
JC #6				FSL/FNL		FEL/FWL	Swd	
JC #2	SEC. 2	15-025-10098 C NE SW	1980	FSL/FNL	1980	FEL/FWL	Oil	NOT Equipped
JC #3	SEC 2	15-025-10099 C NW NW	660	FSL/FNL	660	FEL/FWL	Oil	NOT Equipped
				FSL/FNL		FEL/FWL		
				FSL/FNL		FEL/FWL		
ATTACHED


A SEPARATE SHEET MAY BE ATTACHED IF NECESSARY


*When transferring a unit which consists of more than one lease please file a separate side two for each lease.

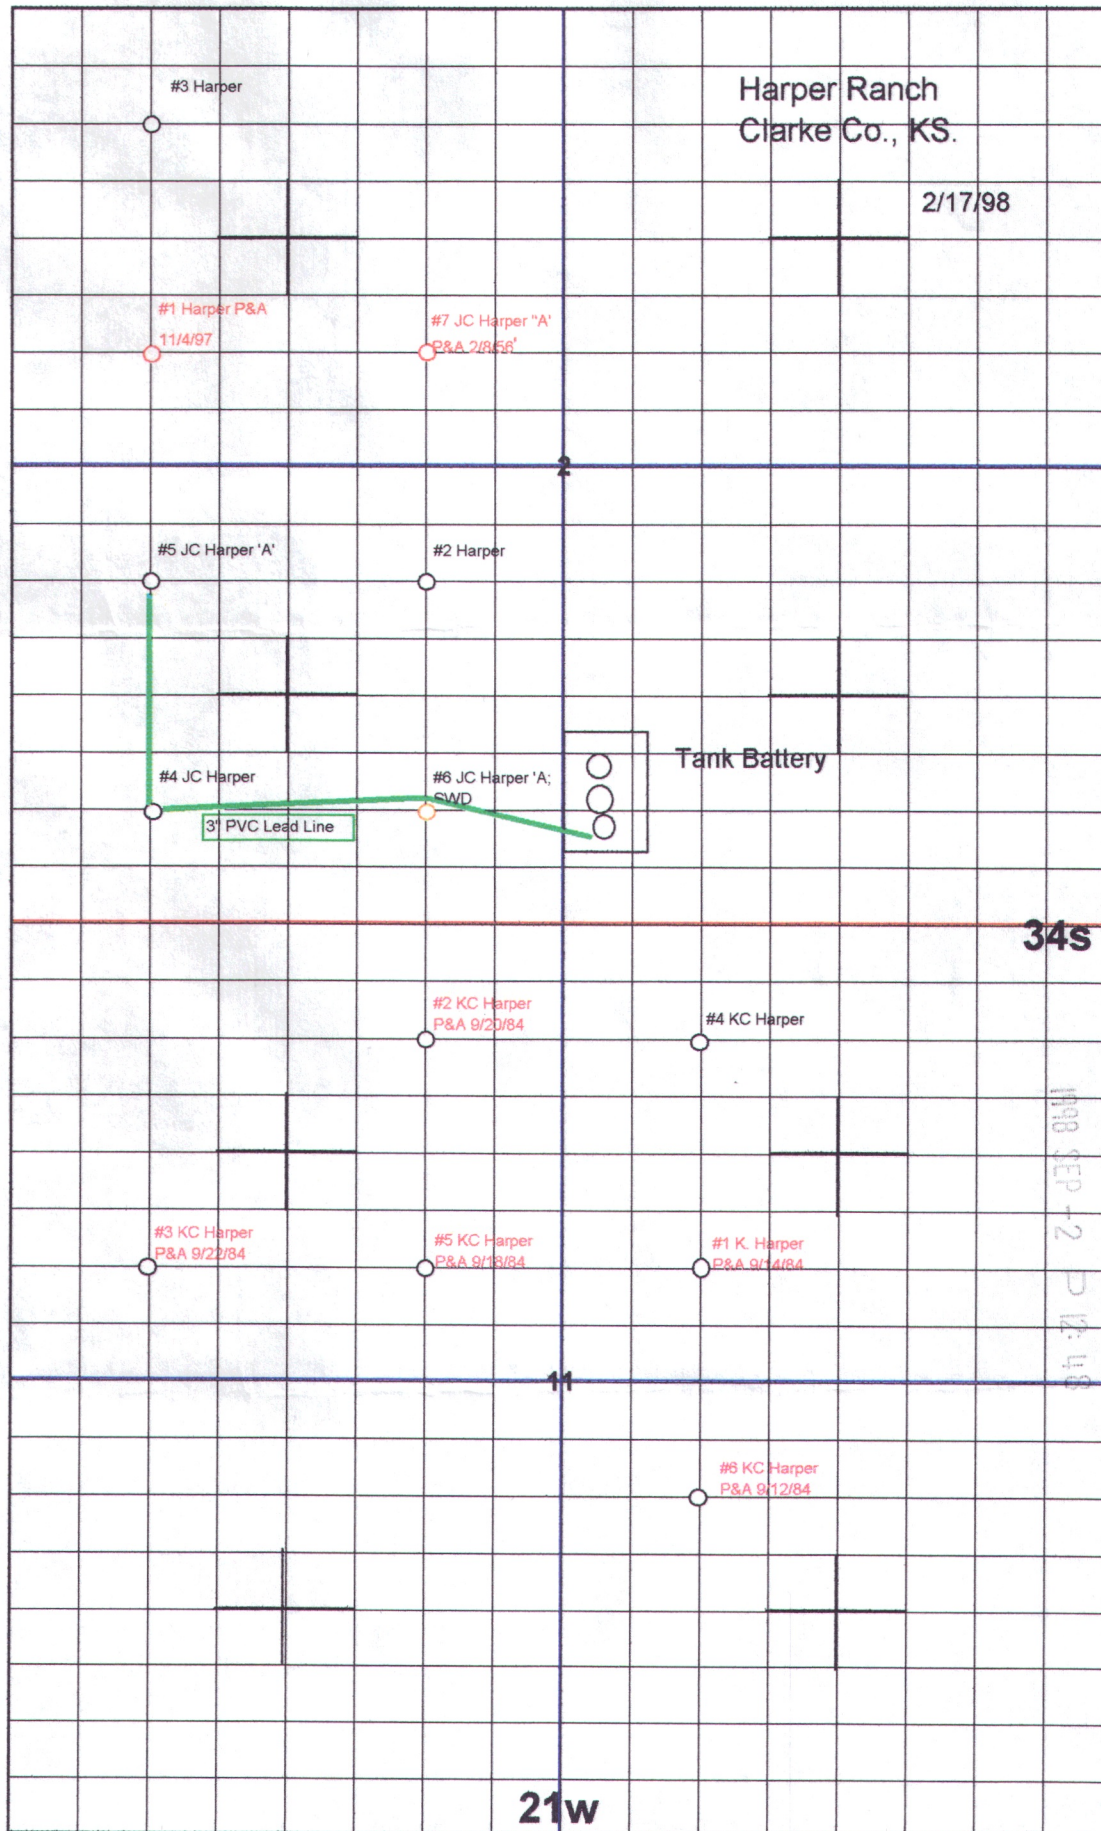

RECEIVED
KANSAS CORP COMM

198 SEP -2 P 12:48

 

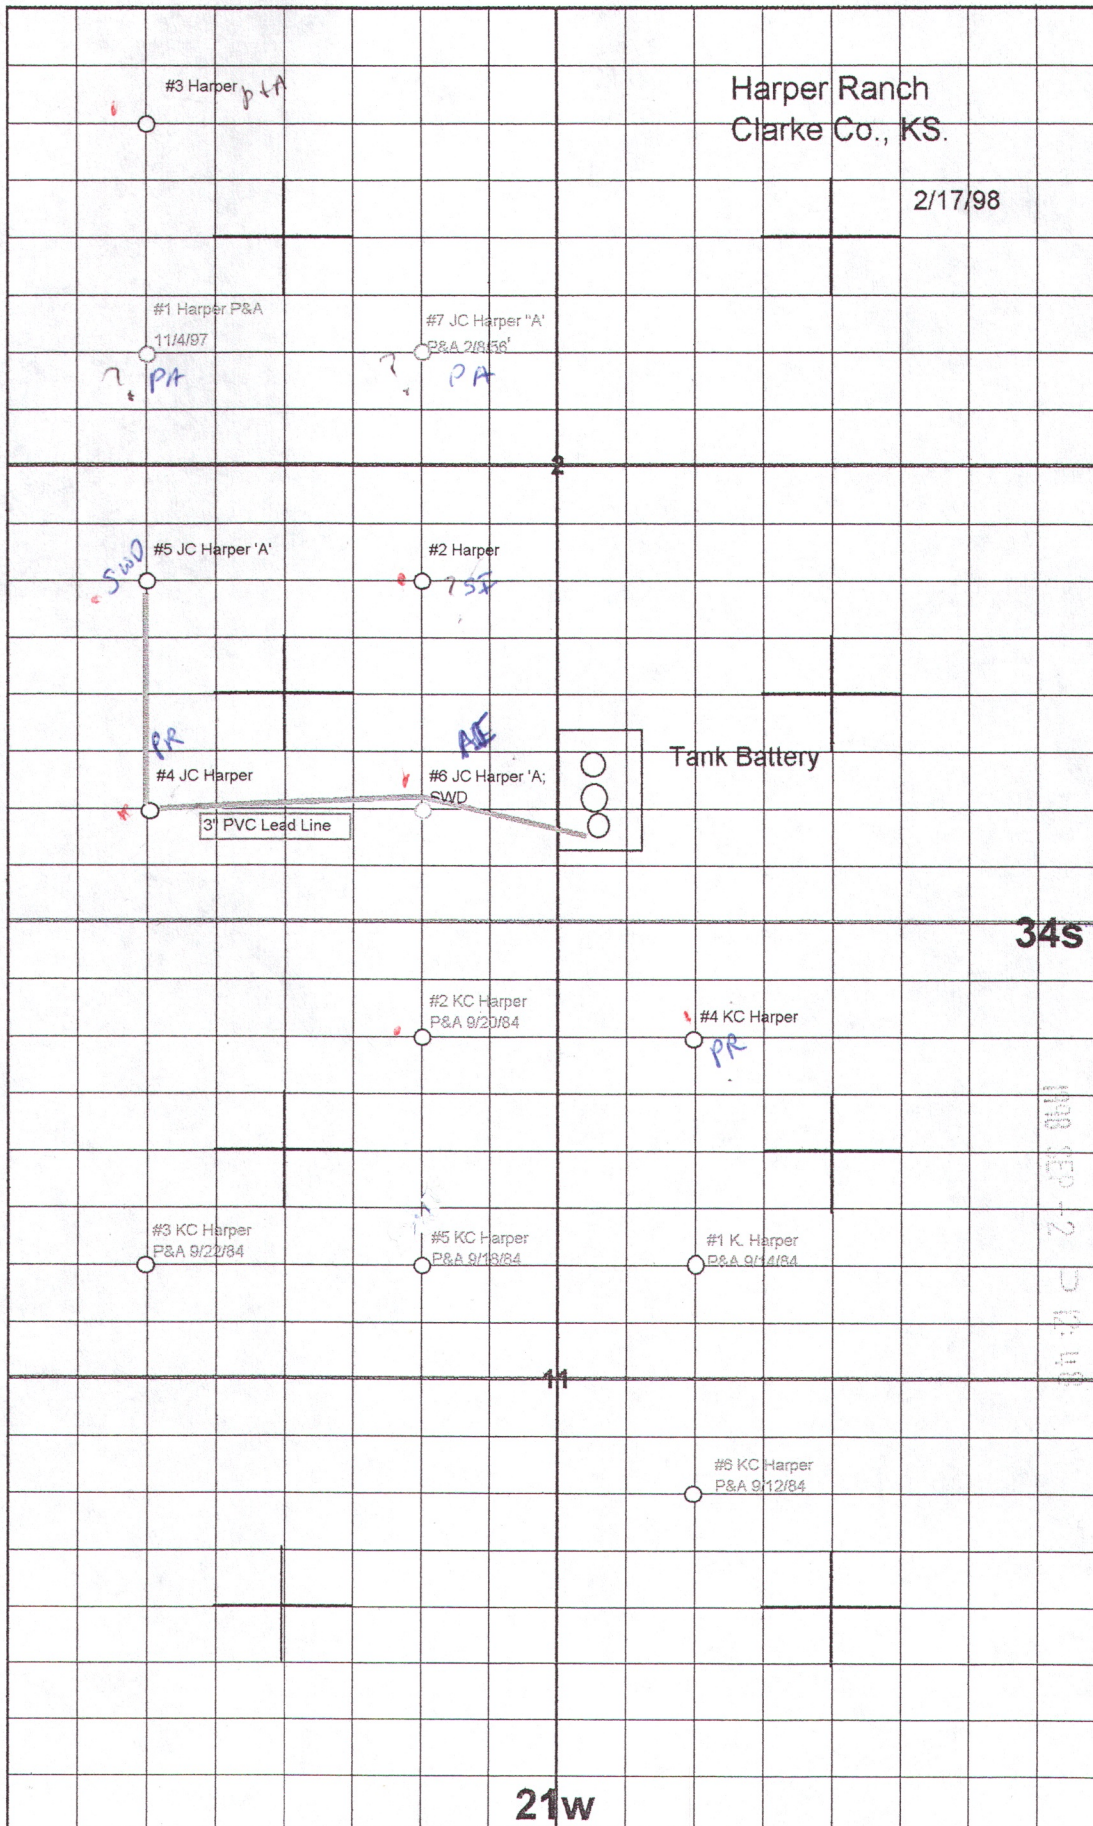

TC
Harper

KC Harper

RECEIVED
KANSAS CORP CONT
198 SEP 2 10 48

21w

ASSIGNMENT OF OIL AND GAS LEASE

KNOW ALL PERSONS BY THESE PRESENTS that 4-D Petroleum Consultants, L.L.C., hereinafter called Assignor, for and in consideration of the sum of One Dollar (\$1.00) cash in hand paid and other good and valuable consideration, the receipt of which is hereby acknowledged, does hereby grant, sell, convey, transfer, assign, and deliver, unto Debra K. Armer, hereinafter called Assignee, a 3% overriding royalty interest in the oil and gas lease dated May 9, 1951, by and between Jesse C. Harper and Melville Campbell Harper, his wife, as Lessors, and The Pure Oil Company, as Lessee, recorded in Book 15 at Page 285 of the records of the Register of Deeds Office of Clark County, Kansas, of all the oil, gas and other minerals in and under, and which may be produced from the following-described land situated in Clark County, Kansas, to-wit:

All of Section 2, Township 34 South, Range 21 West of the 6th P.M., Clark County, Kansas; and

100% of the working interest in the oil and gas lease dated May 9, 1951, by and between Katherine Campbell Harper, a/k/a/ Katherine C. Harper, a single person, as Lessors, and The Pure Oil Company, as Lessee, recorded in Book 15 at Page 286 of the records of the Register of Deeds Office of Clark County, Kansas, of all the oil, gas and other minerals in and under, and which may be produced from the following-described land situated in Clark County, Kansas, to-wit:

All of Section 11, Township 34 South, Range 21 West of the 6th P.M., Clark County, Kansas.

free and clear of any and all expenses of any nature whatsoever, except state and federal taxes.

TO HAVE AND TO HOLD the above-described property and easement, together with all and singular the rights, privileges and

STATE OF KANSAS
County of Clark
The instrument hereby recorded
13th day of March 1998
8:45 P.M. and
recorded in Book 121 Page 49
Epps 3.8.00
Debra K. Armer

CHRISTENSEN,
JOHNSTON
& EISENHAUER
ATTORNEYS AT LAW

Assignment of Oil and Gas lease

appurtenances thereunto in anywise belonging unto said Assignee herein, his heirs, successors, personal representatives, administrators, executors and assigns forever.

And for the same consideration, the Assignor covenants with the Assignee, his heirs, successors or assigns: that the Assignor is the lawful owner of and has good title to the interest above-assigned; and that the Assignor will warrant and forever defend the same against all persons whosever, lawfully claiming or to claim the same.

WITNESS my hand this 3 day of March, 1998.

4-D Petroleum Consultants, L.L.C.

By:



Richard G. Armer, Manager

STATE OF KANSAS)

SS:


COUNTY OF PRATT)


BE IT REMEMBERED that on this 3rd day of March, 1998, before me, the undersigned, a Notary Public, in and for the County and State aforesaid, personally appeared Richard G. Armer, as Manager of 4-D Petroleum Consultants, L.L.C., known to me to be the person who executed the foregoing instrument and such person duly acknowledged the execution of the same on behalf of Pratt Well Service, Inc., for the purposes therein expressed.

IN WITNESS WHEREOF, I have hereunto set my hand and affixed my official seal the day and year last above-written.

(Seal)

CHRISTENSEN,
JOHNSTON
& EISENHAUER
ATTORNEYS AT LAW

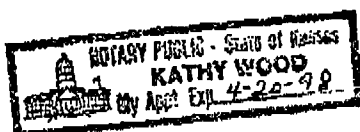

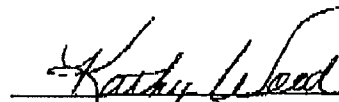
Notary Public