

KANSAS CORPORATION COMMISSION  
OIL & GAS CONSERVATION DIVISION

041013\_Fitzpatrick.pdf Form T-1

March 2010

Form must be Typed  
Form must be Signed  
All blanks must be Filled

**REQUEST FOR CHANGE OF OPERATOR  
TRANSFER OF INJECTION OR SURFACE PIT PERMIT**

Form KSONA-1, Certification of Compliance with the Kansas Surface Owner Notification Act,  
MUST be submitted with this form.

Check Applicable Boxes:

- ☒ Oil Lease: No. of Oil Wells 3 \*\*  
☐ Gas Lease: No. of Gas Wells \_\_\_\_\_ \*\*  
☐ Gas Gathering System: \_\_\_\_\_  
☐ Saltwater Disposal Well - Permit No.: \_\_\_\_\_  
Spot Location: \_\_\_\_\_ feet from ☐ N / ☐ S Line  
\_\_\_\_\_ feet from ☐ E / ☐ W Line  
☐ Enhanced Recovery Project Permit No.: \_\_\_\_\_  
Entire Project: ☐ Yes ☐ No  
Number of Injection Wells \_\_\_\_\_ \*\*

Field Name: NORTH IOLA

**\*\* Side Two Must Be Completed.**

Effective Date of Transfer: 4/10/13

KS Dept of Revenue Lease No.: ~~114287~~ 114287

Lease Name: FITZPATRICK LEASE

\_\_\_\_\_ W/2 - SW Sec. 9 Twp. 24 R. 18 ☒ E ☐ W

Legal Description of Lease: W/2 SW/4

County: ALLEN RECEIVED  
KANSAS CORPORATION COMMISSION

Production Zone(s): BARTLESVILLE **MAY 06 2013**

Injection Zone(s): NONE CONSERVATION DIVISION  
WICHITA, KS

Surface Pit Permit No.: \_\_\_\_\_  
(API No. if Drill Pit, WO or Haul)

\_\_\_\_\_ feet from ☐ N / ☐ S Line of Section

\_\_\_\_\_ feet from ☐ E / ☐ W Line of Section

Type of Pit: ☐ Emergency ☐ Burn ☐ Settling ☐ Haul-Off ☐ Workover ☒ Drilling

Past Operator's License No. 34136 ✓

Contact Person: EDWARD R. FITZPATRICK

Past Operator's Name & Address: EDWARD R. FITZPATRICK

Phone: 620-963-7233

FITZPATRICK OIL COMPANY 1850 WILLOW RD, NEOSHO FALLS, KS 66758

Date: 5/14/2013

Title: OWNER

Signature: Edward R. Fitzpatrick

New Operator's License No. 5150 ✓

Contact Person: DENNIS KERSHNER

New Operator's Name & Address: COLT ENERGY, INC

Phone: 620-365-3111

P O BOX 388

Oil / Gas Purchaser: COFFEYVILLE RESOURCES, LLC

IOLA, KS 66749

Date: 5/14/13

Title: OFFICE MANAGER

Signature: Dennis Kershner

**Acknowledgment of Transfer:** The above request for transfer of injection authorization, surface pit permit # \_\_\_\_\_ has been noted, approved and duly recorded in the records of the Kansas Corporation Commission. This acknowledgment of transfer pertains to Kansas Corporation Commission records only and does not convey any ownership interest in the above injection well(s) or pit permit.

\_\_\_\_\_ is acknowledged as  
the new operator and may continue to inject fluids as authorized by  
Permit No.: \_\_\_\_\_ . Recommended action: \_\_\_\_\_

Date: \_\_\_\_\_  
Authorized Signature: \_\_\_\_\_

\_\_\_\_\_ is acknowledged as  
the new operator of the above named lease containing the surface pit  
permitted by No.: \_\_\_\_\_ .

Date: \_\_\_\_\_  
Authorized Signature: \_\_\_\_\_

DISTRICT \_\_\_\_\_ EPR 5/14/13 PRODUCTION 5.20.13 UIC 5-20-13  
Mail to: Past Operator \_\_\_\_\_ New Operator \_\_\_\_\_ District \_\_\_\_\_


Mail to: KCC - Conservation Division, 130 S. Market - Room 2078, Wichita, Kansas 67202

\* Location: W/2 SW/4 9-24-18 ALLEN CO, KS

*A separate sheet may be attached if necessary*

\* When transferring a unit which consists of more than one lease please file a separate side two for each lease. If a lease covers more than one section please indicate which section each well is located.

Cold Energy, Inc  
Fitzpatrick Lease Sec 9-24-18E Allen Co. Ls.  
for T-1 Change of Operator Page 2

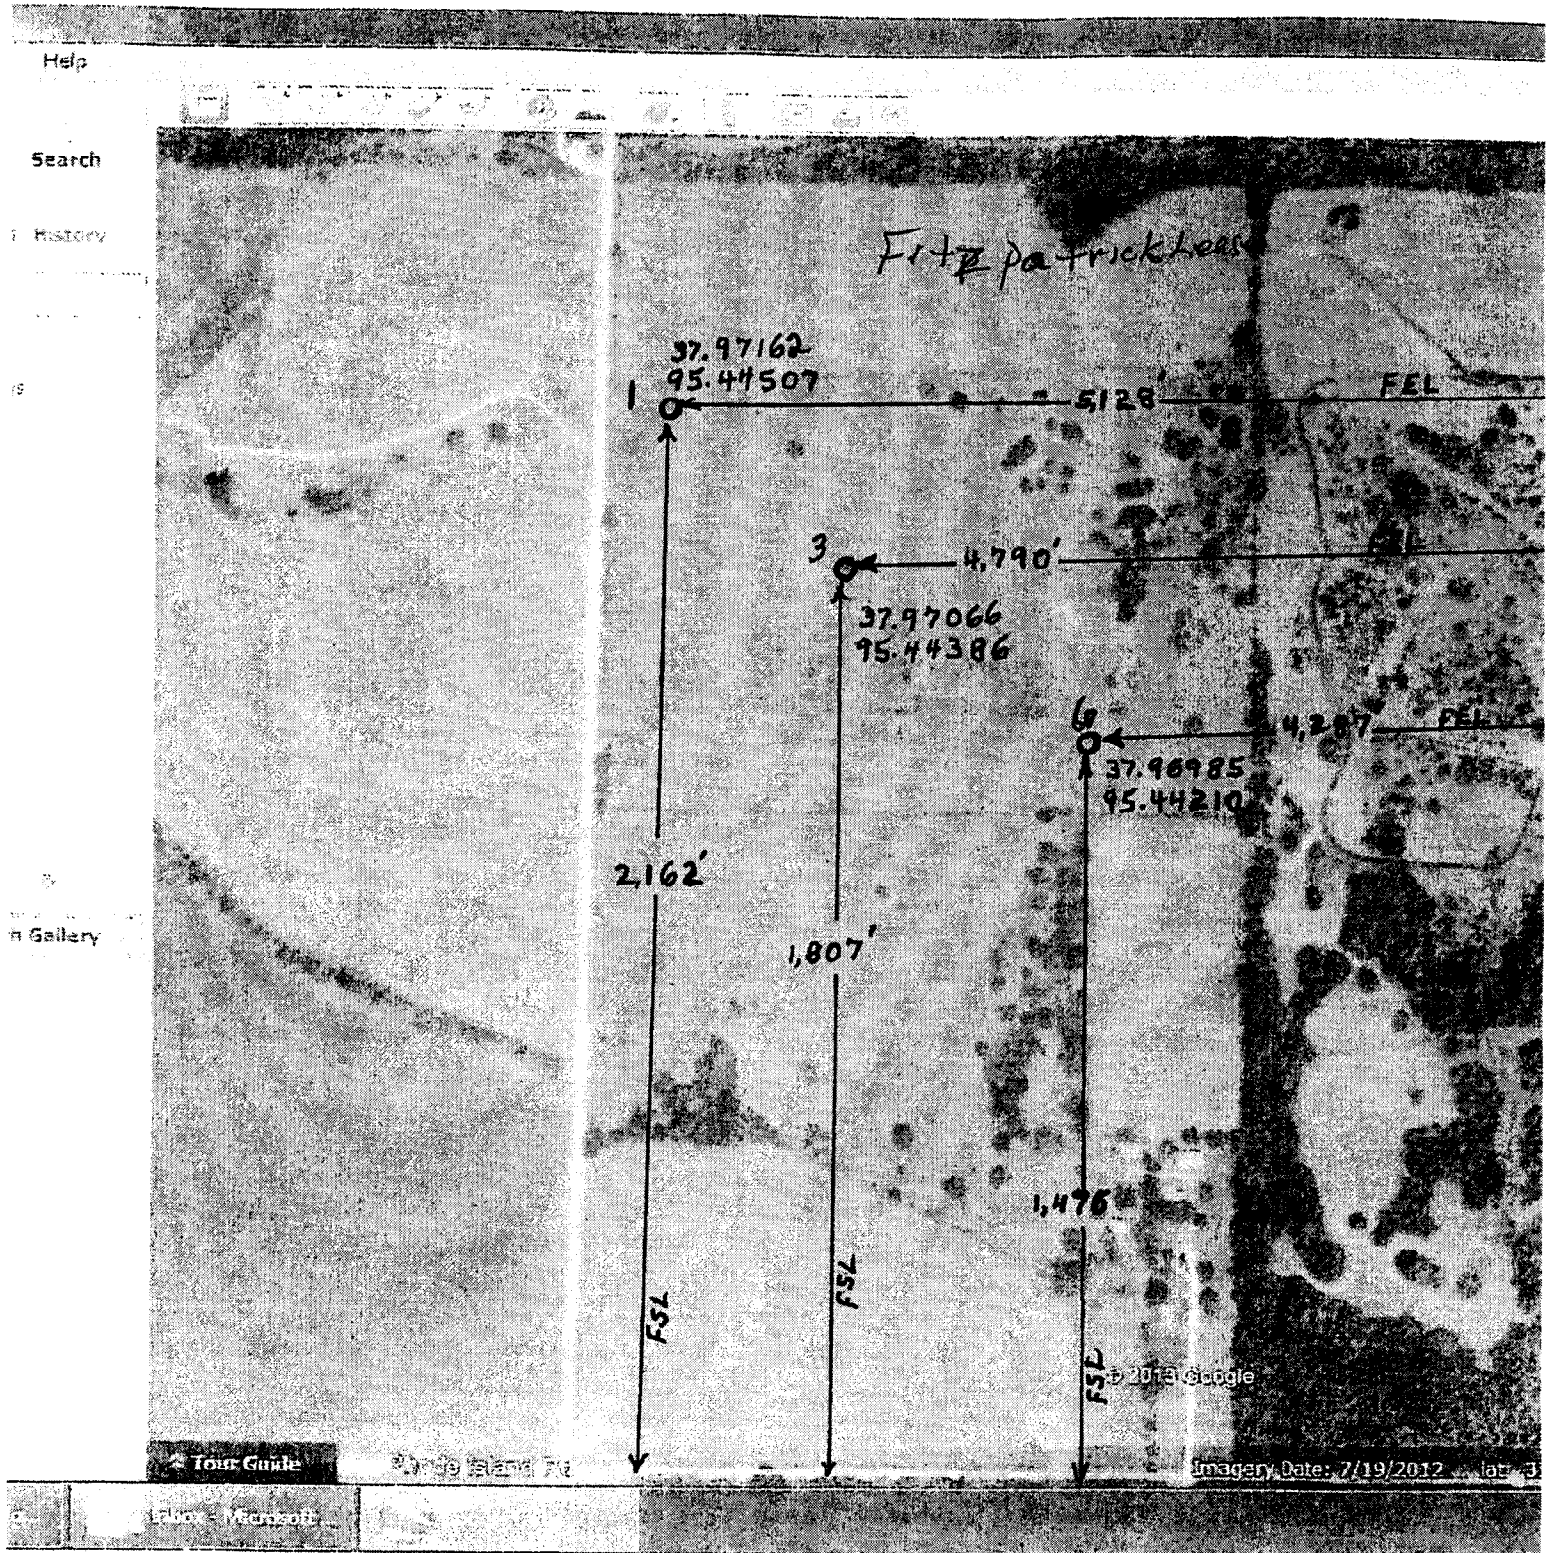

KANSAS CORPORATION COMMISSION  
OIL & GAS CONSERVATION DIVISION

Form KSONA-1  
July 2010  
Form Must Be Typed  
Form must be Signed  
All blanks must be Filled

**CERTIFICATION OF COMPLIANCE WITH THE  
KANSAS SURFACE OWNER NOTIFICATION ACT**

*This form must be submitted with all Forms C-1 (Notice of Intent to Drill); CB-1 (Cathodic Protection Borehole Intent); T-1 (Request for Change of Operator Transfer of Injection or Surface Pit Permit); and CP-1 (Well Plugging Application). Any such form submitted without an accompanying Form KSONA-1 will be returned.*

Select the corresponding form being filed: ☐ C-1 (Intent) ☐ CB-1 (Cathodic Protection Borehole Intent) ☒ T-1 (Transfer) ☐ CP-1 (Plugging Application)

OPERATOR: License # 5150  
Name: COLT ENERGY, INC  
Address 1: P O BOX 388  
Address 2: \_\_\_\_\_  
City: IOLA State: KS Zip: 66749 + \_\_\_\_\_  
Contact Person: DENNIS KERSHNER  
Phone: ( 620 ) 365-3111 Fax: ( 620 ) 365-3170  
Email Address: \_\_\_\_\_

Well Location:  
\_\_\_\_\_-\_\_\_\_\_-\_\_\_\_\_- Sec. \_\_\_\_\_ Twp. \_\_\_\_\_ S. R. \_\_\_\_\_ ☐ East ☐ West  
County: ALLEN  
Lease Name: FITZPATRICK Well #: \_\_\_\_\_

*If filing a Form T-1 for multiple wells on a lease, enter the legal description of the lease below:*

W/2 SW/4 SEC.9 TWP24 RGE18E

RECEIVED  
KANSAS CORPORATION COMMISSION

**MAY 06 2013**

**Surface Owner Information:**

Name: EDWARD R. FITZPATRICK  
Address 1: 1850 WILLOW RD  
Address 2: \_\_\_\_\_  
City: NEOSHO FALLS State: KS Zip: 66758 + \_\_\_\_\_

CONSERVATION DIVISION  
WICHITA, KS

*When filing a Form T-1 involving multiple surface owners, attach an additional sheet listing all of the information to the left for each surface owner. Surface owner information can be found in the records of the register of deeds for the county, and in the real estate property tax records of the county treasurer.*

*If this form is being submitted with a Form C-1 (Intent) or CB-1 (Cathodic Protection Borehole Intent), you must supply the surface owners and the KCC with a plat showing the predicted locations of lease roads, tank batteries, pipelines, and electrical lines. The locations shown on the plat are preliminary non-binding estimates. The locations may be entered on the Form C-1 plat, Form CB-1 plat, or a separate plat may be submitted.*

**Select one of the following:**

- ☒ I certify that, pursuant to the Kansas Surface Owner Notice Act (House Bill 2032), I have provided the following to the surface owner(s) of the land upon which the subject well is or will be located: 1) a copy of the Form C-1, Form CB-1, Form T-1, or Form CP-1 that I am filing in connection with this form; 2) if the form being filed is a Form C-1 or Form CB-1, the plat(s) required by this form; and 3) my operator name, address, phone number, fax, and email address.
- ☐ I have not provided this information to the surface owner(s). I acknowledge that, because I have not provided this information, the KCC will be required to send this information to the surface owner(s). To mitigate the additional cost of the KCC performing this task, I acknowledge that I am being charged a \$30.00 handling fee, payable to the KCC, which is enclosed with this form.

*If choosing the second option, submit payment of the \$30.00 handling fee with this form. If the fee is not received with this form, the KSONA-1 form and the associated Form C-1, Form CB-1, Form T-1, or Form CP-1 will be returned.*

I hereby certify that the statements made herein are true and correct to the best of my knowledge and belief.

Date: 5-1-13 Signature of Operator or Agent: Shirley Statler Title: Production Clerk