

Correction

WATER WELL RECORD

Form WWC-5


Division of Water Resources App. No.

1 LOCATION OF WATER WELL: County: Ottawa, Fraction SE 1/4, NE 1/4, SW 1/4, SW 1/4, Section Number 21, Township No. T 10 S, Range Number R 3

Street/Rural Address of Well Location; if unknown, distance & direction from nearest town or intersection: HWY 81, Minneapolis, KS 67467

2 WATER WELL OWNER: USACE, RR#, Street Address, Box #: HWY 81, City, State, ZIP Code: Minneapolis, KS 67467

Global Positioning System (GPS) information: Latitude: 39.182, Longitude: -97.670, Elevation: 1319.09

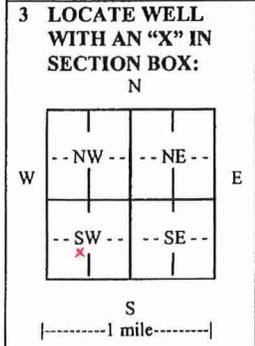

4 DEPTH OF COMPLETED WELL: 18-19.5 ft. Depth(s) Groundwater Encountered (1) N/A, (2) N/A, (3) N/A. WELL'S STATIC WATER LEVEL: 14.60 ft. below land surface measured on 08/25/15

5 TYPE OF CASING USED: Steel, PVC, Other. CASING JOINTS: Glued, Clamped, Welded, Threaded. Casing diameter: 2 in. to 10.9.3 ft.

TYPE OF SCREEN OR PERFORATION MATERIAL: Steel, Stainless Steel, PVC, Brass, Galvanized Steel, None used (open hole). SCREEN OR PERFORATION OPENINGS ARE: Continuous slot, Mill slot, Gauze wrapped, Torch cut, Drilled holes, None (open hole)

6 GROUT MATERIAL: Neat cement, Cement grout, Bentonite, Other High Solids Bent. Grout. Grout Intervals: From 1 ft. to 12.8.3 ft.

Table with columns FROM, TO, LITHOLOGIC LOG, FROM, TO, LITHO. LOG (cont.) or PLUGGING INTERVALS. Includes entries like Top Soil/wRoots, Clay/Sand/Gravel/Silt, Clay, Sand/Gravel, Clay, Sand, Clay, 8" FM.

7 CONTRACTOR'S OR LANDOWNER'S CERTIFICATION: This water well was constructed, reconstructed, or plugged under my jurisdiction and was completed on (mo/day/year) 9/16/2015...

INSTRUCTIONS: Use typewriter or ball point pen. PLEASE PRESS FIRMLY and PRINT clearly. Please fill in blanks and check the correct answers.