

Correction

WATER WELL RECORD


Form WWC-5

Division of Water Resources App. No.

1 LOCATION OF WATER WELL: County: Ottawa	Fraction <u>SE 1/4, SE 1/4, SW 1/4, SW 1/4</u> 1/4 SW 1/4 SW 1/4 SE 1/4	Section Number 21	Township No. T 10 S	Range Number R 3 <input type="checkbox"/> E <input checked="" type="checkbox"/> W
--	---	----------------------	------------------------	--

Street/Rural Address of Well Location; if unknown, distance & direction from nearest town or intersection: If at owner's address, check here <input type="checkbox"/> HWY 81 Minneapolis, KS 67467	Global Positioning System (GPS) information: Latitude: ... <u>39.161</u> (in decimal degrees) Longitude: ... <u>-97.665</u> (in decimal degrees) Elevation: ... <u>1313.34</u> Datum: <input checked="" type="checkbox"/> WGS 84, <input type="checkbox"/> NAD 83, <input type="checkbox"/> NAD 27 Collection Method: <input type="checkbox"/> GPS unit (Make/Model:) <input checked="" type="checkbox"/> Digital Map/Photo, <input type="checkbox"/> Topographic Map, <input type="checkbox"/> Land Survey Est. Accuracy: <input type="checkbox"/> <3 m, <input type="checkbox"/> 3-5 m, <input checked="" type="checkbox"/> 5-15 m, <input type="checkbox"/> >15 m
--	---

2 WATER WELL OWNER: USACE RR#, Street Address, Box #: HWY 81 City, State, ZIP Code : Minneapolis, KS 67467	
---	--

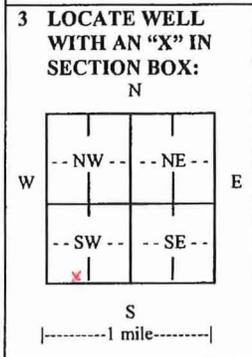

4 DEPTH OF COMPLETED WELL 27 23.3 ft.

Depth(s) Groundwater Encountered (1) N/A ft. (2)..... ft. (3)..... ft.

WELL'S STATIC WATER LEVEL 13.65 ft. below land surface measured on mo/day/yr 08/25/15

Pump test data: Well water was.....ft. after..... hours pumping..... gpm

EST. YIELD.....gpm. Well water was.....ft. after..... hours pumping..... gpm

Bore Hole Diameter 2.75 in. to 27 ft., and.....in. to.....ft.

WELL WATER TO BE USED AS: Public water supply Geothermal Injection well
 Domestic Feedlot Oil field water supply Dewatering Other (Specify below)
 Irrigation Industrial Domestic-lawn & garden Monitoring well GMW-1214

Was a chemical/bacteriological sample submitted to Department? Yes No

If yes, mo/day/yr sample was submitted.....

Water well disinfected? Yes No

5 TYPE OF CASING USED: Steel PVC Other

CASING JOINTS: Glued Clamped Welded Threaded

Casing diameter2..... in. to 10.13 ft., Diameter in. to..... ft., Diameter in. to..... ft.

Casing height above land surface.....0..... in., Weightlbs./ft., Wall thickness or gauge No. Sch 40

TYPE OF SCREEN OR PERFORATION MATERIAL:
 Steel Stainless Steel PVC Other (Specify)

SCREEN OR PERFORATION OPENINGS ARE:
 Continuous slot Mill slot Gauze wrapped Torch cut Drilled holes None (open hole)
 Louvered shutter Key punched Wire wrapped Saw cut Other (specify)

SCREEN-PERFORATED INTERVALS: From 10.13 ft. to 27.23 ft., From..... ft. to..... ft.

GRAVEL PACK INTERVALS: From 8.11 ft. to 27 ft., From..... ft. to..... ft.

6 GROUT MATERIAL: Neat cement Cement grout Bentonite Other High Solids Bent. Grout

Grout Intervals: From 1 ft. to 12.11 ft., From..... ft. to..... ft., From..... ft. to..... ft.

What is the nearest source of possible contamination:
 Septic tank Lateral lines Pit privy Livestock pens Insecticide storage Other (specify below)
 Sewer lines Cesspool Sewage lagoon Fuel storage Abandoned water well
 Watertight sewer lines Seepage pit Feedyard Fertilizer storage Oil well/gas well Former Atlas Missile Site

Direction from well Former UST on Site..... Distance from well within 250 ft.

FROM	TO	LITHOLOGIC LOG	FROM	TO	LITHO. LOG (cont.) or PLUGGING INTERVALS
0	3'	Top Soil			
3'	<u>27'21"</u>	Clay			RECEIVED
<u>21'</u>	<u>21.5'</u>	Sand			OCT 01 2025
<u>21.5'</u>	<u>27'</u>	Clay			BUREAU OF WATER
0	1'	8" FM			
		w/2'x2'x1' Concrete Pad			

7 CONTRACTOR'S OR LANDOWNER'S CERTIFICATION: This water well was constructed, reconstructed, or plugged under my jurisdiction and was completed on (mo/day/year) 08/06/2015 and this record is true to the best of my knowledge and belief.

Kansas Water Well Contractor's License No. 903 This Water Well Record was completed on (mo/day/year) 9/11/15

under the business name of ROBERTS ENV. DRILLING, INC. by (signature) [Signature]

INSTRUCTIONS: Use typewriter or ball point pen. **PLEASE PRESS FIRMLY** and **PRINT** clearly. Please fill in blanks and check the correct answers. Send three copies (white, blue, pink) to Kansas Department of Health and Environment, Bureau of Water, Geology Section, 1000 SW Jackson St., Suite 420, Topeka, Kansas 66612-1367. Telephone 785-296-5522. Send one copy to WATER WELL OWNER and retain one for your records. Include fee of \$5.00 for each constructed well. Visit us at <http://www.kdheks.gov/waterwell/index.html>.