



**DRILLERS TEST LOG**

CUSTOMER NAME Forrest Cox DATE 2-5-81  
 STREET ADDRESS \_\_\_\_\_ TEST # 1 E Log - Yes  
 CITY & STATE Sublette, KS DRILLER Mai  
 COUNTY Haskell QUARTER NW SECTION 2 TOWNSHIP 28 RANGE 32

LOCATION 1320' South & 60' East of NW corner of 1/4

Well Location

#	DRILLED FROM	PAY	FOOTAGE TO	DESCRIPTION OF STRATA	STATIC WATER LEVEL
					PROPOSED WELL DEPTH
	0		3	Top Soil	
	3		19	Brown clay	
	19		40	Brown clay & fine sand	
	40		56	Sand - fine	
	56		79	Brown sandy clay & sand - fine, cemented in places	
	79		93	Sand - fine to med	
	93		103	Brown sandy clay	
	103		128	Sand - fine to med coarse small to med gravel few large drills rough	
	128		134	Brown clay	
	134		207	sand- fine to med coarse small to med gravel & few large	
	207		215	Sandy clay & small sand stks	
	215		223	Sand - fine to med coarse small to med gravel	
	223		236	Brown clay cemented sand stks, few sand stks	
	236		244	Sand - fine to med coarse small & few med gravel	
	244		260	Brown & gray clay sticky	
	260		310	Blue clay sticky very few blue sand stks	
65	310	40	350	Sand - fine to med coarse small to med gravel small clay stks	
	350		355	Brown clay & limerock	
70	355	23	378	Sand - fine to med coarse small to med gravel	
	378		382	Brown clay & hard blue clay	
60	382	09	391	Sand - fine to med coarse small to med gravel & sandy clay stks	
	391		400	Brown & brown sandy clay	
55	400	05	405	Sand - fine to med coarse small gravel cemented in places	
	405		407	Brown & white clay	
45	407	10	417	Sand - fine to med coarse cemented loose in places	
	417		432	Brown clay	
55	432	14	446	Sand - fine to med coarse	
	446		495	Brown & white clay few limerock ledges, sticky, few small sand stks	
30	495	11	506	Sand - fine & small clay stks	
	506		527	Brown clay	
70	527	20	547	Sand - fine to med coarse small & few med brown & tan rock.	
45	547	38	585	Fine sand, few brown rock, few hard clay stks uses water	
20	585	15	600	Hard brown clay & fine sand	
40	600	09	609	Brown & red fine sand uses little water	
	609		620	Weathered shale with red clay stks	
				Total Depth of well = 612'	
				Set up facing south. Dig pit on the West	
				3 Sacks Quik Gel	

**HENKLE DRILLING & SUPPLY CO., INC.**

GARDEN CITY, KANSAS  
Phone 276-3278

SUBLETTE, KANSAS  
Phone 675-4311

TEST HOLES

DOMESTIC WELLS

STOCK WELLS

IRRIGATION & INDUSTRIAL WELLS

TEST HOLE MAP

HENKLE DRILLING & SUPPLY CO., INC.

CUSTOMER Forrest Cox


DATE 2-5-81

ADDRESS Sublette, KS

TEST NO. 1

COUNTY Haskell QTR. NW SEC. 2 TWP. 28 RNG 33

LOCATION \_\_\_\_\_

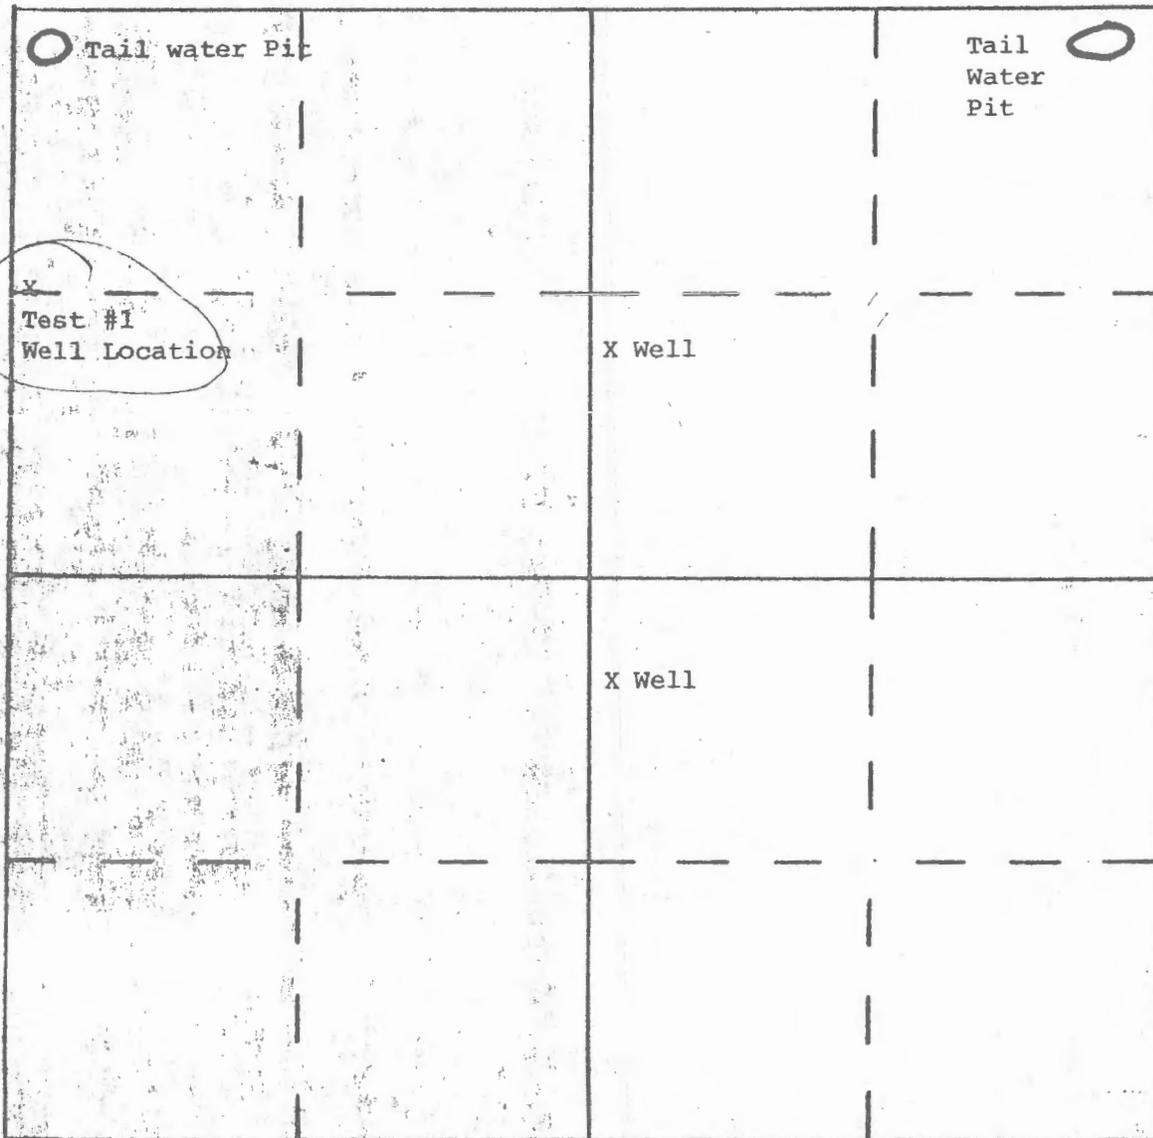

← 1 MILE →

HENKLE DRILLING & SUPPLY CO., INC.

DRILLER Tim Mai