

County: Haskell Fraction: NW NW NW Sec. 16 T. 30 S R. 32 W

CORRECTION(S) to WATER WELL COMPLETION RECORD Form WWC-5 (to rectify lacking or incorrect information)

Owner: Ruth Wright Trust Tr. Irrigation

If location corrected, was listed as:

Section-Township-Range: 5-31S-32W

Location changed to:

16-30S-32W

Fraction (1/4 calls): _____

Other changes: Initial statements: Casing height after plugging incorrectly reported as 8 in above ground surface. Lat./long. not reported. County reported incorrectly as Seward.

Changed to: Casing height is 44 in below land surface. Well is located in Haskell County.
(37.445327, -100.834272) WGS84.

Comments: _____

Verification method: Confirmed information with Leon Birney Construction, Google Earth, and LeoWeb.

Initials: BA Date: 10/14/25

Submitted by: Kansas Geological Survey, Data Resources Library, 1930 Constant Ave., Lawrence, KS 66047-3724
 Kansas Dept. of Health & Environment, Bureau of Water, 1000 SW Jackson, Suite 420, Topeka, KS 66612-1367


1 LOCATION OF WATER WELL: County: Seward Fraction: NW 1/4 NW 1/4 NW 1/4 1/4 Section Number: 5 Township Number: T 31 S 32 Range Number: E W

Street/Rural Address of Well Location; if unknown, distance & direction from nearest town or intersection: If at owner's address, check here 180' S.E. of intersection of Road N and Road 28

Global Positioning Systems (GPS) information:
 Latitude: _____ (in decimal degrees)
 Longitude: _____ (in decimal degrees)
 Elevation: _____
 Horizontal Datum: WGS84, NAD83, NAD27
 Collection Method: _____

2 WATER WELL OWNER: Ruth Wright Trust, TR
 RR#, St. Address, Box #: 2108 Hwy. 83
 City, State ZIP Code: Sublette Ks. 67877

GPS unit (Make/Model: _____)
 Digital Map/Photo, Topographic Map, Land Survey
 Est. Accuracy: < 3 m, 3-5 m, 5-15 m, > 15 m

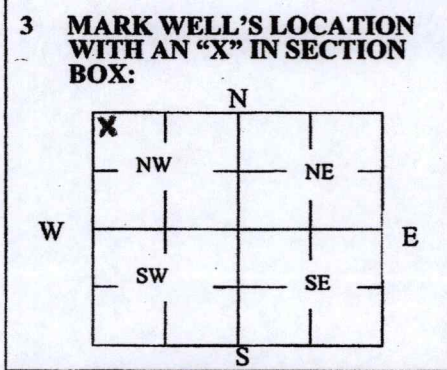

4 DEPTH OF WELL 380 ft.
 WELL'S STATIC WATER LEVEL 344 ft.
 WELL WAS USED AS:
 Domestic Public Water Supply Dewatering
 Irrigation Oil Field Water Supply Monitoring
 Feedlot Domestic (Lawn & Garden) Injection Well
 Industrial Air Conditioning Other _____
 Was a chemical/bacteriological sample submitted to Department? Yes No

5 TYPE OF BLANK CASING USED:

Steel RMP (SR) Wrought Fiberglass Other (Specify below)
 PVC ABS Asbestos-Cement Concrete Tile

Blank casing diameter 16 in. Was casing pulled? Yes No If yes, how much _____
 Casing height above or below land surface 8 in.

6 GROUT PLUG MATERIAL: Neat cement Cement grout Bentonite Other _____

Grout Plug Intervals: From _____ ft. to _____ ft., From _____ ft. to _____ ft., From _____ ft. to _____ ft.

What is the nearest source of possible contamination:
 Septic tank Seepage pit Fuel storage Other (specify below)
 Sewer lines Pit privy Fertilizer storage
 Watertight sewer lines Sewage lagoon Insecticide storage
 Lateral lines Feedyard Abandoned water well Direction from well? West
 Cess pool Livestock pens Oil well/Gas well How many feet? 1000'

FROM	TO	PLUGGING MATERIALS	FROM	TO	PLUGGING MATERIALS
380	344	Sand			
380	344	Bleach			
344	341	Bentonite			
341	314	Clay			
314	6.5	Sand			
6.5	3.5	Bentonite			
3.5	0	Clay			

7 CONTRACTOR'S OR LANDOWNER'S CERTIFICATION: This water well was plugged under my jurisdiction and was completed on (mo/day/year) 10-18-2024 and this record is true to the best of my knowledge and belief. Kansas Water Well Contractor's License No. _____ This Water Well Record was completed on (mo/day/year) _____ under the business name of Leon Birney Const by (signature) Leon Birney

**NPS POLLUTION CONTROL FUNDS
ABANDONED WATER WELL COST-SHARE PROGRAM
(WELL PLUGGING WORKSHEET)**

WORKSHEET: Use water quality bulletin to complete this worksheet, available through County Extension Service

NAME: Ruth Wright Trust, TR COUNTY: ~~WHEEL~~ Seward DATE: 10-18-24

TYPE OF WELL: Drilled Hand Dug

Diameter (Inside): 16 inches Diameter (Outside): 16 1/2 inches Depth to Water: 344 Total Depth: 380

TOP SOIL: 3.5 feet

BENTONITE PLUG: 3 feet

SUBSOIL: 334.5
(# Value in Feet)

3' Bentonite plug
SAND (to water level):
36' feet

RECEIVED

TOP SOIL NEEDED:
4.2 cu. feet/foot x 3.5 feet = 14.7 cubic feet
14.7 cubic ft. / 1 cu. yd/27 cu. ft. = .5 cu. yds.

BENTONITE NEEDED:
PLUG: 4.2 cu.ft/ft x 3 ft. = 9 cu.ft.
GROUT SEAL RESTORATION:
9 cu. ft. x 1 bag/0.7 cu.ft. = 6 bags

SUBSOIL NEEDED:
4.7 cu.ft./ft. x 334.5 ft. = 569 cu. feet
(Number of feet) (Number of cubic feet)
569 cu. ft. / 1 cu. yd/27 cu. ft. = 21.0 cu. yds.

SAND NEEDED:
1.40 cu.ft./ft. x 36 ft. = 50.4 cu. ft.
50.4 cu. ft. / 1 cu. yd/27 cu. ft. = 1.8 cu. yds.
CHLORINE NEEDED:
12.77 oz./ft. x 36 ft. = 459 oz.
459 oz. x 0.121 = 3.79 gal

SITE PREPARATION: REMOVE PUMP AND COLUMN PIPE AND DEBRIS. EXCAVATE AROUND DRILLED WELL CASING AND CUT CASING 3 FEET BELOW GROUND LEVEL. STOCKPILE FILL MATERIAL ON SITE. LEAVE IN TRUCK IF POSSIBLE. HANDDUG WELLS NEED TRACTOR WITH FRONT END LOAD OR LARGE PRY BARS TO CAVE IN ROCK LINING.