County: Haskell Fraction: SW SW SE Sec. 29 T. 28 S R. 33 W

CORRECTION(S) to WATER WELL COMPLETION RECORD **Form WWC-5** (to rectify lacking or incorrect information)

Owner: Roberta York Revocable Trust Irrigation

If location corrected, was listed as:	**Location changed to:**
Section-Township-Range:	
Fraction (¼ calls): SE SE SW	SW SW SE

Other changes: Initial statements: Casing Height after plugging incorrectly reported as 10 in above ground surface. Lat./Long. not reported.

Changed to: Casing Height is 46 in below land surface. Well location, (37.576927, -100.952949) WGS84.

Comments:

Verification method: Confirmed information with Leon Birney Construction, Google Earth, and LeoWeb.

Initials: BA Date: 8/31/26

Submitted by:
- ☐ Kansas Geological Survey, Data Resources Library, 1930 Constant Ave., Lawrence, KS 66047-3724
- ■ Kansas Dept. of Health & Environment, Bureau of Water, 1000 SW Jackson, Suite 420, Topeka, KS 66612-1367

(rev 01/26/2018)

WATER WELL PLUGGING RECORD Form WWC-5P KSA 82a-1212 ID NO.

1 LOCATION OF WATER WELL: County: Haskell | Fraction: SE¼ SE¼ SW¼ ¼ | Section Number: 29 | Township Number: 28 T 33 S | Range Number: ☐ E ☒ W

Street/Rural Address of Well Location; if unknown, distance & direction from nearest town or intersection: If at owner's address, check here ☐ ½ mile west of Co. Road II+ 120th 100' north

Global Positioning Systems (GPS) information:
Latitude: _____ (in decimal degrees)
Longitude: _____ (in decimal degrees)
Elevation: _____
Horizontal Datum: ☐ WGS84, ☐ NAD83, ☐ NAD27
Collection Method:
☐ GPS unit (Make/Model: _____)
☐ Digital Map/Photo, ☐ Topographic Map, ☐ Land Survey
Est. Accuracy: ☐ <3 m, ☐ 3-5 m, ☐ 5-15 m, ☐ >15 m

2 WATER WELL OWNER: Roberta York Revocable Trust
RR#, St. Address, Box #: 1161 Rd JJ
City, State ZIP Code: Sublette Ks. 67877

3 MARK WELL'S LOCATION WITH AN "X" IN SECTION BOX:

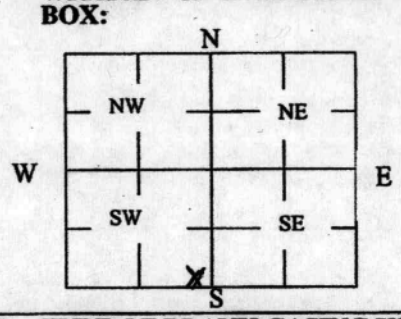

4 DEPTH OF WELL 538 ft. Water right number 15463-00 1 of 2 wells c in 3
WELL'S STATIC WATER LEVEL 410 ft
WELL WAS USED AS:

☐ Domestic	☐ Public Water Supply	☐ Dewatering	
☒ Irrigation	☐ Oil Field Water Supply	☐ Monitoring	
☐ Feedlot	☐ Domestic (Lawn & Garden)	☐ Injection Well	
☐ Industrial	☐ Air Conditioning	☐ Other _____	

Was a chemical/bacteriological sample submitted to Department? Yes ☐ No ☐

5 TYPE OF BLANK CASING USED:

☒ Steel	☐ RMP (SR)	☐ Wrought	☐ Fiberglass	☐ Other (Specify below)
☐ PVC	☐ ABS	☐ Asbestos-Cement	☐ Concrete Tile	

Blank casing diameter 16" in. Was casing pulled? Yes ☐ No ☒ If yes, how much _____
Casing height above or below land surface 10" in.

6 GROUT PLUG MATERIAL: ☐ Neat cement ☐ Cement grout ☒ Bentonite ☐ Other _____

Grout Plug Intervals: From _____ ft. to _____ ft., From _____ ft. to _____ ft., From _____ ft. to _____ ft.

What is the nearest source of possible contamination:

☐ Septic tank	☐ Seepage pit	☐ Fuel storage	☐ Other (specify below)
☐ Sewer lines	☐ Pit privy	☐ Fertilizer storage	
☐ Watertight sewer lines	☐ Sewage lagoon	☐ Insecticide storage	
☐ Lateral lines	☐ Feedyard	☐ Abandoned water well	Direction from well? _____
☐ Cess pool	☐ Livestock pens	☐ Oil well/Gas well	How many feet? _____

FROM	TO	PLUGGING MATERIALS	FROM	TO	PLUGGING MATERIALS
538	414	Sand			
414	414	Bleach			
414	411	Bentonite			
417	414	Clay			
6.5'	417	Sand			
3.5'	6.5'	Bentonite			
0	3.5'	Clay			

7 CONTRACTOR'S OR LANDOWNER'S CERTIFICATION: This water well was plugged under my jurisdiction and was completed on (mo/day/year) 01-28-2025 and this record is true to the best of my knowledge and belief. Kansas Water Well Contractor's License No. _____. This Water Well Record was completed on (mo/day/year) 01-29-2025 under the business name of Leon Birney Construction by (signature) Leon Birney

Send one white copy to Kansas Department of Health & Environment, Geology Section, 1000 SW Jackson Street, Ste. 420, Topeka, KS 66612-1367. Send one copy to WATER WELL OWNER and retain one for your records.
Visit us at http://www.kdheks.gov/waterwell/index.html Telephone 785-296-5524.

3565
7265

KSA82a-1212 Revised 1/20/2015

NPS POLLUTION CONTROL FUNDS
ABANDONED WATER WELL COST-SHARE PROGRAM
(WELL PLUGGING WORKSHEET)

WORKSHEET: Use water quality bulletin to complete this worksheet, available through County Extension Service

NAME: _____ COUNTY: HASKELL DATE: 01-28-2025

TYPE OF WELL: Drilled X Hand Dug ____ 4-30-1968

Diameter (Inside): 15 3/4 inches Diameter (Outside): 16" inches Depth to Water: 381 Total Depth: 538

TOP SOIL: 3.5 feet

BENTONITE PLUG: 3 feet

SUBSOIL: 417'
(# Value in Feet)

3' Bentonite Plug

SAND (to water level):
111.5 feet

TOP SOIL NEEDED:
4.2 cu. feet/feet x 3.5 feet = 14.7 cubic feet
14.7 cubic ft. / 1 cu. yd/27 cu. ft. = .5 cu. yds.

BENTONITE NEEDED:
PLUG: 4.2 cu.ft/ft x 3 ft. = 9 cu.ft.

GROUT SEAL RESTORATION:
9 cu. ft. x 1 bag/0.7 cu.ft. = 6 bags

SUBSOIL NEEDED:
4.7 cu.ft/ft. x 417 ft. = 1959.9 cu. feet
(Number of feet) (Number of cubic feet)
1959.9 cu. ft. / 1 cu. yd/27 cu. ft. = 72.59 cu. yds.

SAND NEEDED:
1.40 cu.ft/ft. x 111.5 ft. = 156.1 cu. ft.
156.1 cu. ft. / 1 cu. yd/27 cu. ft. = 5.78 cu. yds.

CHLORINE NEEDED:
12.77 oz./ft. x 111.5 ft. = 1423.8 oz.
1423.8 oz. x 0 121 = 11.76 0

SITE PREPARATION: REMOVE PUMP AND COLUMN PIPE AND DEBRIS. EXCAVATE AROUND DRILLED WELL CASING AND CUT CASKING 3 FEET BELOW GROUND LEVEL. STOCKPILE FILL MATERIAL ON SITE. LEAVE IN TRUCK IF POSSIBLE. HANDDUG WELLS NEED TRACTOR WITH FRONT END LOAD OR LARGE PRY BARS TO CAVE IN ROCK LINING.

RETURN THIS PAGE TO THE HASKELL COUNTY CONSERVATION DISTRICT