

County: Finney Fraction: SE SE SE NW Sec. 24 T. 26 S R. 32 W

CORRECTION(S) to WATER WELL COMPLETION RECORD Form WWC-5 (to rectify lacking or incorrect information)

Owner: T+O LLC Irrig (315' TD)

If location corrected, was listed as:

Location changed to:

Section-Township-Range: _____

Fraction (1/4 calls): SE SE NW

SE SE SE NW

Other changes: Initial statements: Blank casing diam., and casing type not listed. Lat./Long incorrect.

Was casing pulled? Not answ. Well located away from address given for well location.

Changed to: Casing height is 36 in below land surface. Blank casing diam. is 16" and type is steel.

(37.773657, -100.771234) NAD83. From S Co RD. 18 & E TV Rd. well is 1/2 mi E and 2,400 ft S.

Comments: _____

Verification method: Confirmed information with Western Sprinklers, LeoWeb & KDHE's STR Finder.

Initials: BA Date: 8/31/26

Submitted by: ☐ Kansas Geological Survey, Data Resources Library, 1930 Constant Ave., Lawrence, KS 66047-3724
☒ Kansas Dept. of Health & Environment, Bureau of Water, 1000 SW Jackson, Suite 420, Topeka, KS 66612-1367

WATER WELL PLUGGING RECORD Form WWC-5P

KSA 82a-1212

ID NO.

1 LOCATION OF WATER WELL: County: <u>Finney</u>	Fraction: <u>1/4 S E 1/4 E 1/4 NW 1/4</u>	Section Number: <u>24</u>	Township Number: <u>T 26 S</u>	Range Number: <u>32</u> ☐ E ☒ W
---	---	---------------------------	--------------------------------	--

Street/Rural Address of Well/Location; if unknown, distance & direction from nearest town or intersection: If at owner's address, check here ☒ 5250 E TV Rd Garden City K.S. 67846

Global Positioning Systems (GPS) information:


Latitude: 37.772769 (in decimal degrees)
Longitude: -100.770652 (in decimal degrees)
Elevation: _____

Horizontal Datum: ☐ WGS84, ☐ NAD83, ☐ NAD27
Collection Method: _____

2 WATER WELL OWNER: T40 LLC
RR#, St. Address, Box #: P.O. Box 1178
City, State ZIP Code: Liberal K.S. 67901

☐ GPS unit (Make/Model: _____)
☐ Digital Map/Photo, ☐ Topographic Map, ☐ Land Survey
Est. Accuracy: ☐ < 3 m, ☐ 3-5 m, ☐ 5-15 m, ☐ > 15 m

3 MARK WELL'S LOCATION WITH AN "X" IN SECTION BOX:

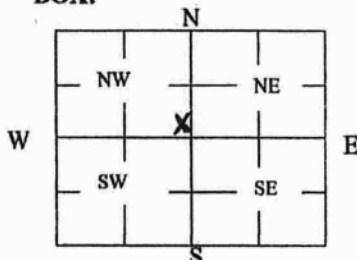

4 DEPTH OF WELL 315' ft.

WELL'S STATIC WATER LEVEL 270' ft

WELL WAS USED AS:

- | | | |
|---|---|---|
| ☒ Domestic Irrigation | ☐ Public Water Supply | ☐ Dewatering |
| ☐ Feedlot | ☐ Oil Field Water Supply | ☐ Monitoring |
| ☐ Industrial | ☐ Domestic (Lawn & Garden) | ☐ Injection Well |
| | ☐ Air Conditioning | ☐ Other _____ |

Was a chemical/bacteriological sample submitted to Department? Yes ☐ No ☐

5 TYPE OF BLANK CASING USED:

- ☐ Steel ☐ RMP (SR) ☐ Wrought ☐ Fiberglass ☐ Other (Specify below)
☐ PVC ☐ ABS ☐ Asbestos-Cement ☐ Concrete Tile

Blank casing diameter _____ in. Was casing pulled? Yes ☐ No ☐ If yes, how much _____
Casing height above or below land surface 36 in.

6 GROUT PLUG MATERIAL:

- ☐ Neat cement ☐ Cement grout ☒ Bentonite ☐ Other _____

Grout Plug Intervals: From 3 ft. to 6 ft., From _____ ft. to _____ ft., From _____ ft. to _____ ft.

What is the nearest source of possible contamination:

- | | | | |
|---|---|--|--|
| ☐ Septic tank | ☐ Seepage pit | ☐ Fuel storage | ☐ Other (specify below) _____ |
| ☐ Sewer lines | ☐ Pit privy | ☐ Fertilizer storage | |
| ☐ Watertight sewer lines | ☐ Sewage lagoon | ☐ Insecticide storage | |
| ☐ Lateral lines | ☐ Feedyard | ☒ Abandoned water well | |
| ☐ Cess pool | ☐ Livestock pens | ☐ Oil well/Gas well | |

Direction from well? NW
How many feet? 2800

FROM	TO	PLUGGING MATERIALS	FROM	TO	PLUGGING MATERIALS
0	3	Top Soil			
3	6	Bentonite			
6	270	Clay			
270	315	Washed Sand			

RECEIVED

FEB 20 2025

BUREAU OF WATER

7 CONTRACTOR'S OR LANDOWNER'S CERTIFICATION: This water well was plugged under my jurisdiction and was completed on (mo/day/year) 2-25 and this record is true to the best of my knowledge and belief, Kansas Water Well Contractor's License No. 722. This Water Well Record was completed on (mo/day/year) 2-12-25 under the business name of Western Sprinklers Inc by (signature) [Signature]

Send one white copy to Kansas Department of Health & Environment, Geology Section, 1000 SW Jackson Street, Ste. 420, Topeka, KS 66612-1367. Send one copy to WATER WELL OWNER and retain one for your records.
Visit us at <http://www.kdheks.gov/waterwell/index.html> Telephone 785-296-5524.

KSA82a-1212

Revised 1/20/2015