County: Haskell Fraction: SE SW SE Sec. 28 T. 28 S R. 33 W

CORRECTION(S) to WATER WELL COMPLETION RECORD **Form WWC-5** (to rectify lacking or incorrect information)

Owner: Pete York Revocable Trust Irrigation

If location corrected, was listed as:	**Location changed to:**
Section-Township-Range:	
Fraction (¼ calls): SW SE SE	SE SW SE

Other changes: Initial statements: Casing height after plugging incorrectly reported as 10 in above ground surface. Lat./long. not reported. Date of completion not reported.

Changed to: Casing height is 3 ft 10 in in below land surface. Plugging was completed on 5/21/24. (37.576929, -100.930438) WGS84.

Comments:

Verification method: Confirmed information with Leon Birney Construction, Google Earth, and LeoWeb.

Initials: BA Date: 10/13/25

Submitted by:
- ☐ Kansas Geological Survey, Data Resources Library, 1930 Constant Ave., Lawrence, KS 66047-3724
- ■ Kansas Dept. of Health & Environment, Bureau of Water, 1000 SW Jackson, Suite 420, Topeka, KS 66612-1367

(rev 01/26/2018)

KDHE SCANNED

Copy

WATER WELL PLUGGING RECORD Form WWC-5P KSA 82a-1212 ID NO.

1 LOCATION OF WATER WELL: County: Haskell | Fraction: SW¼ SE¼ SE¼ ¼ | Section Number: 28 | Township Number: T 28 S 33 | Range Number: 33 ☐ E ☒ W

Street/Rural Address of Well Location; if unknown, distance & direction from nearest town or intersection. If at owner's address, check here ☐ Co. Road JJ & 120th
1234' West & 70' North

Global Positioning Systems (GPS) information:
Latitude: _____ (in decimal degrees)
Longitude: _____ (in decimal degrees)
Elevation: _____
Horizontal Datum: ☐ WGS84, ☐ NAD83, ☐ NAD27
Collection Method:
☐ GPS unit (Make/Model: _____)
☐ Digital Map/Photo, ☐ Topographic Map, ☐ Land Survey
Est. Accuracy: ☐ <3 m, ☐ 3-5 m, ☐ 5-15 m, ☐ >15 m

2 WATER WELL OWNER: Pete York Revocable Trust
RR#, St. Address, Box #: 1161 ROAD JJ
City, State ZIP Code: Sublette Ks 67877

3 MARK WELL'S LOCATION WITH AN "X" IN SECTION BOX:

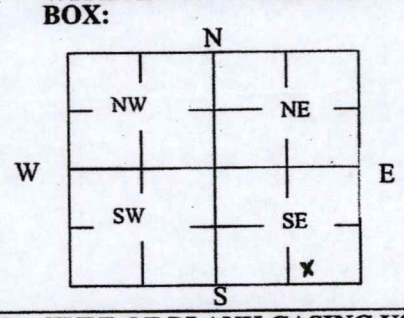

4 DEPTH OF WELL 534' ft.
WELL'S STATIC WATER LEVEL 420' ft
WELL WAS USED AS:

☐ Domestic	☐ Public Water Supply	☐ Dewatering
☒ Irrigation	☐ Oil Field Water Supply	☐ Monitoring
☐ Feedlot	☐ Domestic (Lawn & Garden)	☐ Injection Well
☐ Industrial	☐ Air Conditioning	☐ Other _____

Was a chemical/bacteriological sample submitted to Department? Yes ☐ No ☒

5 TYPE OF BLANK CASING USED:

☒ Steel	☐ RMP (SR)	☐ Wrought	☐ Fiberglass	☐ Other (Specify below)
☐ PVC	☐ ABS	☐ Asbestos-Cement	☐ Concrete Tile	_____

Blank casing diameter 16 in. Was casing pulled? Yes ☐ No ☒ If yes, how much _____
Casing height (above) or below land surface 10 in.

6 GROUT PLUG MATERIAL: ☐ Neat cement ☐ Cement grout ☒ Bentonite ☐ Other _____

Grout Plug Intervals: From 420' ft. to 417' ft., From 6.5 ft. to 3.5 ft., From _____ ft. to _____ ft.

What is the nearest source of possible contamination:

☒ Septic tank	☐ Seepage pit	☐ Fuel storage	☐ Other (specify below)
☒ Sewer lines	☐ Pit privy	☐ Fertilizer storage	_____
☐ Watertight sewer lines	☐ Sewage lagoon	☐ Insecticide storage	
☒ Lateral lines	☐ Feedyard	☐ Abandoned water well	Direction from well? E
☐ Cess pool	☐ Livestock pens	☐ Oil well/Gas well	How many feet? 1320'

FROM	TO	PLUGGING MATERIALS	FROM	TO	PLUGGING MATERIALS
510'	420'	Washed Sand			
510'	420'	Bleach			
420'	417'	Bentonite			
417'	415'	Clay			
415'	6.5'	Sand			
6.5	3.5	Bentonite			
3.5	0	Clay			

7 CONTRACTOR'S OR LANDOWNER'S CERTIFICATION: This water well was plugged under my jurisdiction and was completed on (mo/day/year) _____ and this record is true to the best of my knowledge and belief. Kansas Water Well Contractor's License No. _____. This Water Well Record was completed on (mo/day/year) _____ under the business name of Leon Birney Construction by (signature) Leon Birney

Send one white copy to Kansas Department of Health & Environment, Geology Section, 1000 SW Jackson Street, Ste. 420, Topeka, KS 66612-1367. Send one copy to WATER WELL OWNER and retain one for your records.
Visit us at http://www.kdheks.gov/waterwell/index.html Telephone 785-296-5524.

3565
7265

KSA82a-1212 Revised 1/20/2015

KDHE SCANNED

NPS POLLUTION CONTROL FUNDS
ABANDONED WATER WELL COST-SHARE PROGRAM
(WELL PLUGGING WORKSHEET)

WORKSHEET: Use water quality bulletin to complete this worksheet, available through County Extension Service

NAME: Lete York COUNTY: HASKELL DATE: 5-21-24

TYPE OF WELL: Drilled X Hand Dug ____

Diameter (Inside): 16 inches Diameter (Outside): 16½ inches Depth to Water: 390 Total Depth: 510

TOP SOIL: 3.5 feet

BENTONITE PLUG: 3 CU. feet

SUBSOIL: 390 (# Value in Feet)

3' Bentonite plug

SAND (to water level): 420 feet

TOP SOIL NEEDED:
4.2 cu. feet/feet x 3.5 feet = 14.7 cubic feet
14.7 cubic ft. / 1 cu. yd/27 cu. ft. = .5 cu. yds.

BENTONITE NEEDED:
PLUG: 4.2 cu.ft/ft x 3 ft. = 9 cu.ft.

GROUT SEAL RESTORATION:
9 cu. ft. x 1 bag/0.7 cu.ft. = 6 bags

SUBSOIL NEEDED:
1.4 cu.ft/ft. x 390 ft. = 546 cu. feet
(Number of feet) (Number of cubic feet)
546 cu. ft. / 1 cu. yd/27 cu. ft. = 20.22 cu. yds.

SAND NEEDED:
1.40 cu.ft/ft. x 120 ft. = 168 cu. ft.
168 cu. ft. / 1 cu. yd/27 cu. ft. = 6.22 cu. yds.

CHLORINE NEEDED:
12.77 oz./ft. x 120 ft. = 1532.4 oz.
1532.4 oz. ÷ 0 121 oz/gal = 12.77 gal.

SITE PREPARATION: REMOVE PUMP AND COLUMN PIPE AND DEBRIS. EXCAVATE AROUND DRILLED WELL CASING AND CUT CASKING 3 FEET BELOW GROUND LEVEL. STOCKPILE FILL MATERIAL ON SITE. LEAVE IN TRUCK IF POSSIBLE. HANDDUG WELLS NEED TRACTOR WITH FRONT END LOAD OR LARGE PRY BARS TO CAVE IN ROCK LINING.

RETURN THIS PAGE TO THE HASKELL COUNTY CONSERVATION DISTRICT