


1 LOCATION OF WATER WELL: Fraction NE 1/4 NE 1/4 NW 1/4 Section Number 6 Township Number T 29 S Range Number 31 E W
 County: Haskell

Street/Rural Address of Well Location; if unknown, distance & direction from nearest town or intersection: If at owner's address, check here From intersection of HWY 144 and RD 55, it is 1385' east and 40' south
 Global Positioning Systems (GPS) information:
 Latitude: 37.5618659 (in decimal degrees)
 Longitude: -100.7571156 (in decimal degrees)
 Elevation: _____
 Horizontal Datum: WGS84, NAD83, NAD27
 Collection Method: Phone
 GPS unit (Make Model: _____)
 Digital Map Photo. Topographic Map. Land Survey
 Est. Accuracy: < 3 m. 3-5 m. 5-15 m. 15 m

2 WATER WELL OWNER: Jerry Ensz
 RR#, St. Address, Box #: 1620 RD 55
 City, State ZIP Code: Sablette, KS 67887

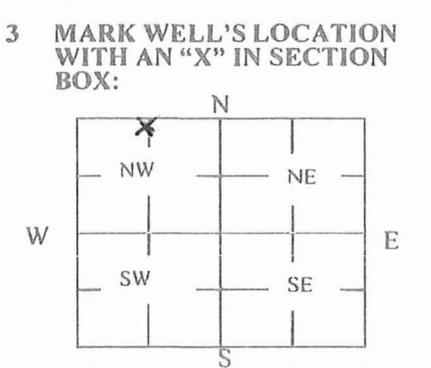

4 DEPTH OF WELL 470 ft.
 WELL'S STATIC WATER LEVEL 315 ft.
 WELL WAS USED AS:
 Domestic Public Water Supply Dewatering
 Irrigation Oil Field Water Supply Monitoring
 Feedlot Domestic (Lawn & Garden) Injection Well
 Industrial Air Conditioning Other _____
 Was a chemical/bacteriological sample submitted to Department? Yes No

5 TYPE OF BLANK CASING USED:
 Steel RMP (SR) Wrought Fiberglass Other (Specify below)
 PVC ABS Asbestos-Cement Concrete Tile
 Blank casing diameter 16 in. Was casing pulled? Yes No If yes, how much _____
 Casing height above or below land surface 60 in. RECEIVED
NOV 24 2025
BUREAU OF WATER

6 GROUT PLUG MATERIAL: Neat cement Cement grout Bentonite Other _____
 Grout Plug Intervals: From 305 ft. to 301 ft., From 9 ft. to 5 ft., From _____ ft. to _____ ft.
 What is the nearest source of possible contamination:
 Septic tank Seepage pit Fuel storage Other (specify below) Irrigation Well
 Sewer lines Pit privy Fertilizer storage
 Watertight sewer lines Sewage lagoon Insecticide storage
 Lateral lines Feedyard Abandoned water well Direction from well? Southwest
 Cess pool Livestock pens Oil well-Gas well How many feet? 2650

FROM	TO	PLUGGING MATERIALS	FROM	TO	PLUGGING MATERIALS
470	305	Sand			
305	301	Bentonite			
301	9	Sub soil			
9	5	Bentonite			

7 CONTRACTOR'S OR LANDOWNER'S CERTIFICATION: This water well was plugged under my jurisdiction and was completed on (mo day/year) 11-11-25 and this record is true to the best of my knowledge and belief. Kansas Water Well Contractor's License No. _____ This Water Well Record was completed on (mo day/year) 11-14-25 under the business name of Smith Irrigation Inc by (signature) [Signature]

Send one white copy to Kansas Department of Health & Environment, Geology Section, 1000 SW Jackson Street, Ste. 420, Topeka, KS 66612-1367. Send one copy to WATER WELL OWNER and retain one for your records.
 Visit us at <http://www.kdheks.gov/waterwell/index.html> Telephone 785-296-5524.