


Well ID

Revised 7/10/2015

RECEIVED

DEC 24 2025

BUREAU OF WATER

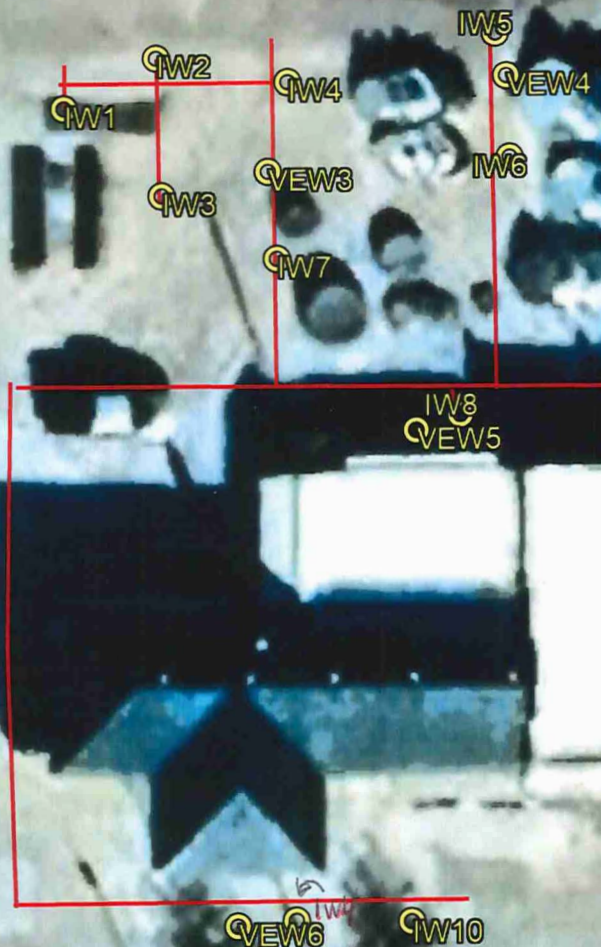

Fresh Seven Coffee Roasters

St. Francis Mercantile Equity Exchange
320 W Washington, St. Francis KS
KDE # 46-012-14962

T.3 R.40W Sec. 22
Cheyenne County

Google Earth

Image © 2025 Airbus

100 ft

