

WATER WELL RECORD Form WWC-5


☒ Original Record ☐ Correction ☐ Change in Well Use

Division of Water
Resources App. No.

Well ID IW10

1 LOCATION OF WATER WELL: County: Cheyenne	Fraction ¼ NW ¼ SW ¼ SW ¼	Section Number 22	Township Number T 3 S	Range Number R 40 ☐ E ☒ W
--	------------------------------	----------------------	--------------------------	---

2 WELL OWNER: Last Name: First: Business: St. Francis Mercantile Equity Exchange Address: 320 W. Washington St. Address: City: St. Francis State: KS ZIP: 67756	Street or Rural Address where well is located (if unknown, distance and direction from nearest town or intersection): If at owner's address, check here: ☒
--	--

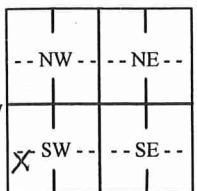3 LOCATE WELL WITH "X" IN SECTION BOX: N  W E S [-----1 mile-----]	4 DEPTH OF COMPLETED WELL: 23 ft. Depth(s) Groundwater Encountered: 1) ft. 2) ft. 3) ft. or 4) ☐ Dry Well WELL'S STATIC WATER LEVEL: ft. ☐ below land surface, measured on (mo-day-yr) ☐ above land surface, measured on (mo-day-yr) Pump test data: Well water was ft. after hours pumping gpm Well water was ft. after hours pumping gpm Estimated Yield: gpm Bore Hole Diameter: 8.25 in. to 23 ft. and in. to ft.	5 Latitude: 39.774312 (decimal degrees) Longitude: -101.805955 (decimal degrees) Horizontal Datum: ☒ WGS 84 ☐ NAD 83 ☐ NAD 27 Source for Latitude/Longitude: ☐ GPS (unit make/model:) (WAAS enabled? ☐ Yes ☐ No) ☐ Land Survey ☐ Topographic Map ☒ Online Mapper: Google Earth
	6 Elevation: 3294 ft. ☒ Ground Level ☐ TOC Source: ☐ Land Survey ☐ GPS ☐ Topographic Map ☒ Other Google Earth	

7 WELL WATER TO BE USED AS:

1. Domestic: ☐ Household ☐ Lawn & Garden ☐ Livestock	2. Irrigation	3. ☐ Feedlot	4. ☐ Industrial	5. ☐ Public Water Supply: well ID	6. ☐ Dewatering: how many wells?	7. ☐ Aquifer Recharge: well ID	8. ☐ Monitoring: well ID	9. Environmental Remediation: well ID IW10 ☐ Air Sparge ☐ Soil Vapor Extraction ☐ Recovery ☒ Injection	10. ☐ Oil Field Water Supply: lease	11. Test Hole: well ID ☐ Cased ☐ Uncased ☐ Geotechnical	12. Geothermal: how many bores? a) Closed Loop ☐ Horizontal ☐ Vertical b) Open Loop ☐ Surface Discharge ☐ Inj. of Water	13. ☐ Other (specify):
--	---------------	-------------------------------------	--	--	---	---	---	---	--	---	---	---

Was a chemical/bacteriological sample submitted to KDHE? ☐ Yes ☒ No If yes, date sample was submitted:
 Water well disinfected? ☐ Yes ☒ No

8 TYPE OF CASING USED: ☐ Steel ☒ PVC ☐ Other CASING JOINTS: ☐ Glued ☐ Clamped ☐ Welded ☒ Threaded
 Casing diameter 2 in. to 21 ft., Diameter in. to ft., Diameter in. to ft.
 Casing height above land surface 0 in. Weight lbs./ft. Wall thickness or gauge No. Sch 40

TYPE OF SCREEN OR PERFORATION MATERIAL:
☐ Steel ☐ Stainless Steel ☐ Fiberglass ☒ PVC ☐ Other (Specify)
☐ Brass ☐ Galvanized Steel ☐ Concrete tile ☐ None used (open hole)

SCREEN OR PERFORATION OPENINGS ARE:
☐ Continuous Slot ☒ Mill Slot ☐ Gauze Wrapped ☐ Torch Cut ☐ Drilled Holes ☐ Other (Specify)
☐ Louvered Shutter ☐ Key Punched ☐ Wire Wrapped ☐ Saw Cut ☐ None (Open Hole)

SCREEN-PERFORATED INTERVALS: From 21 ft. to 23 ft., From ft. to ft., From ft. to ft.
GRAVEL PACK INTERVALS: From 19 ft. to 23 ft., From ft. to ft., From ft. to ft.

9 GROUT MATERIAL: ☐ Neat cement ☐ Cement grout ☒ Bentonite ☐ Other
 Grout Intervals: From 3.5 ft. to 19 ft., From ft. to ft., From ft. to ft.

Nearest source of possible contamination:
☐ Septic Tank ☐ Lateral Lines ☐ Pit Privy ☐ Livestock Pens ☐ Insecticide Storage
☐ Sewer Lines ☐ Cess Pool ☐ Sewage Lagoon ☐ Fuel Storage ☐ Abandoned Water Well
☐ Watertight Sewer Lines ☐ Seepage Pit ☐ Feedyard ☐ Fertilizer Storage ☐ Oil Well/Gas Well
☐ Other (Specify)
 Direction from well? Distance from well? ft.


10 FROM	TO	LITHOLOGIC LOG	FROM	TO	LITHO. LOG (cont.) or PLUGGING INTERVALS
0	0.5	Concrete			
0.5	7	Sand, vf-m, sl. silty, Brn to Lt Brn			
7	12	Silt, sl. sady, sl. clayey, Lt Brn			
12	16	Sand, f-m w/tr c grvl, sl silty, Gray			
16	20	Sand, f-c w/f grvl, Gray Brn to Brn			
20	23	Sand, f-c w/f grvl, tr clayey, Brown			

11 CONTRACTOR'S OR LANDOWNER'S CERTIFICATION: This water well was ☒ constructed, ☐ reconstructed, or ☐ plugged under my jurisdiction and was completed on (mo-day-year) 10/28/2025 and this record is true to the best of my knowledge and belief. Kansas Water Well Contractor's License No. 527 This Water Well Record was completed on (mo-day-year) 11/25/2025 under the business name of GeoCore, LLC Signature _____

RECEIVED

DEC 24 2025

BUREAU OF WATER

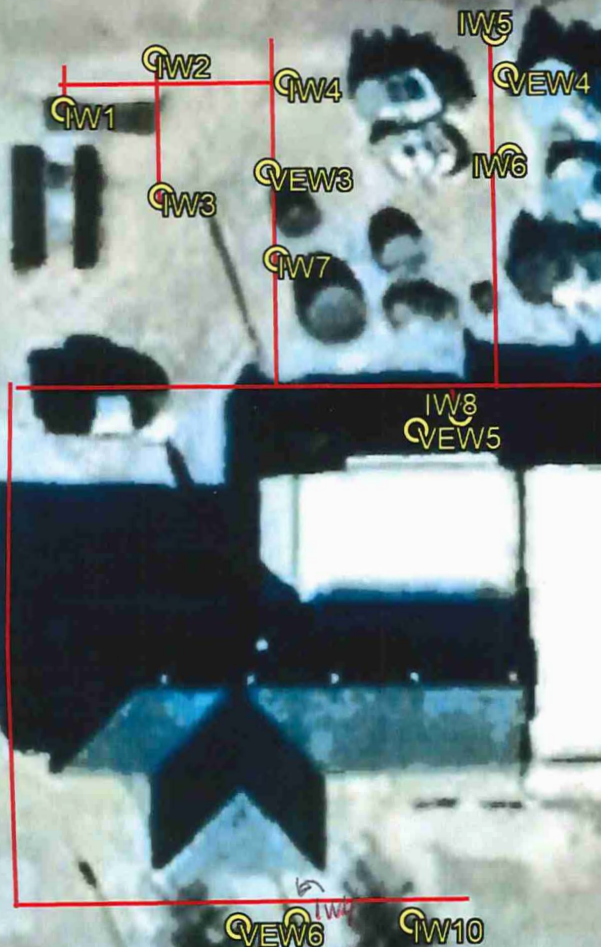

Fresh Seven Coffee Roasters

St. Francis Mercantile Equity Exchange
320 W Washington, St. Francis KS
KDE # 46-012-14962

T.3 R.40W Sec.22
Cheyenne County

Google Earth

Image © 2025 Airbus

100 ft

