

**WATER WELL PLUGGING RECORD Form WWC-5P KSA 82a-1212 ID NO.**

[ ]


**1 LOCATION OF WATER WELL:** Fraction SE 1/4 NE 1/4 SW 1/4 NW 1/4 Section Number 28 Township Number T 24 S Range Number 32  E  W  
 County: Finney

Street/Rural Address of Well Location; if unknown, distance & direction from nearest town or intersection: If at owner's address, check here  1 Mile SE of Garden City, KS

**Global Positioning Systems (GPS) information:**  
 Latitude: 37.941257 (in decimal degrees)  
 Longitude: -100.842858 (in decimal degrees)  
 Elevation: 2843'  
 Horizontal Datum:  WGS84,  NAD83,  NAD27  
 Collection Method:

**2 WATER WELL OWNER:** Damme Partnership  
 RR#, St. Address, Box #: PO Box 1611  
 City, State ZIP Code: Garden City, KS 67846

GPS unit (Make/Model: \_\_\_\_\_)  
 Digital Map/Photo,  Topographic Map,  Land Survey  
 Est. Accuracy:  < 3 m,  3-5 m,  5-15 m,  > 15 m

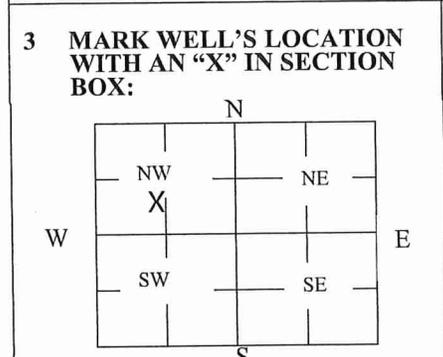

**4 DEPTH OF WELL** 282 ft.  
 WELL'S STATIC WATER LEVEL 256 ft.  
 WELL WAS USED AS:

Domestic  Public Water Supply  Dewatering  
 Irrigation  Oil Field Water Supply  Monitoring  
 Feedlot  Domestic (Lawn & Garden)  Injection Well  
 Industrial  Air Conditioning  Other \_\_\_\_\_

Was a chemical/bacteriological sample submitted to Department? Yes  No

**5 TYPE OF BLANK CASING USED:**

Steel  RMP (SR)  Wrought  Fiberglass  Other (Specify below)  
 PVC  ABS  Asbestos-Cement  Concrete Tile Plugged

Blank casing diameter 16 in. Was casing pulled? Yes  No  If yes, how much 7'  
 Casing height above or below land surface 84 in.  
BA

**6 GROUT PLUG MATERIAL:**  Neat cement  Cement grout  Bentonite  Other \_\_\_\_\_

Grout Plug Intervals: From 267 ft. to 274 ft., From 274 ft. to 275 ft., From \_\_\_\_\_ ft. to \_\_\_\_\_ ft.

What is the nearest source of possible contamination:

Septic tank  Seepage pit  Fuel storage  Other (specify below)  
 Sewer lines  Pit privy  Fertilizer storage Irrigation Well  
 Watertight sewer lines  Sewage lagoon  Insecticide storage  
 Lateral lines  Feedyard  Abandoned water well Direction from well? Northwest  
 Cess pool  Livestock pens  Oil well/Gas well How many feet? 204'

FROM	TO	PLUGGING MATERIALS	FROM	TO	PLUGGING MATERIALS
0	1	Concrete			
1	8	Bentonite			
8	274	Clay Material			
274	282	Gravel Sand			

**RECEIVED**  
**JAN 23 2026**  
**BUREAU OF WATER**

**7 CONTRACTOR'S OR LANDOWNER'S CERTIFICATION:** This water well was plugged under my jurisdiction and was completed on (mo/day/year) 01/07/2026 and this record is true to the best of my knowledge and belief. Kansas Water Well Contractor's License No. \_\_\_\_\_ This Water Well Record was completed on (mo/day/year) 01/09/2026 under the business name of AimX Irrigation Solutions, Inc by (signature) \_\_\_\_\_

Send one white copy to Kansas Department of Health & Environment, Geology Section, 1000 SW Jackson Street, Ste. 420, Topeka, KS 66612-1367. Send one copy to WATER WELL OWNER and retain one for your records.  
 Visit us at <http://www.kdheks.gov/waterwell/index.html> Telephone 785-296-5524.