

County: Wichita Fraction: NW NW SE Sec. 32 T. 17 S R. 36 W

**CORRECTION(S) to WATER WELL COMPLETION RECORD Form WWC-5 (to rectify lacking or incorrect information)**

Owner: Berning Land, LLC Irrigation #3

If location corrected, was listed as:

Section-Township-Range: \_\_\_\_\_

Fraction (1/4 calls): Blank

Location changed to:

\_\_\_\_\_

NW NW SE

Other changes: Initial statements: Quarter fractions and rural address of well location were missing.

Changed to: Well location, (38.531429, -101.321780) WGS84.

Comments: \_\_\_\_\_

Verification method: Unfortunately, the well owner could not be contacted. But this well is visible on Sat. imagery on Google Earth, this was correlated with the well's location in Section #3 on the WWC5P.

Initials: BA Date: 3/16/26


Submitted by:  Kansas Geological Survey, Data Resources Library, 1930 Constant Ave., Lawrence, KS 66047-3724  
 Kansas Dept. of Health & Environment, Bureau of Water, 1000 SW Jackson, Suite 420, Topeka, KS 66612-1367

WATER WELL PLUGGING RECORD Form WWC-5P KSA 82a-1212 ID NO. [ ]

1 LOCATION OF WATER WELL: County: Wichita Fraction 1/4 NW 1/4 NW 1/4 SE 1/4 Section Number 32 SE 14 Township Number T 17 S Range Number 36  E  W

Street/Rural Address of Well Location; if unknown, distance & direction from nearest town or intersection: If at owner's address, check here  Global Positioning Systems (GPS) information: Latitude: \_\_\_\_\_ (in decimal degrees) Longitude: \_\_\_\_\_ (in decimal degrees) Elevation: \_\_\_\_\_ Datum:  WGS84,  NAD83,  NAD27 Collection Method:  GPS unit (Make/Model): \_\_\_\_\_  Digital Map/Photo,  Topographic Map,  Land Survey Est. Accuracy:  < 3 m,  3-5 m,  5-15 m,  > 15 m

2 WATER WELL OWNER: Berning Land, LLC RR#, St. Address, Box #: Box 175 City, State ZIP Code: Leoti, KS 67861

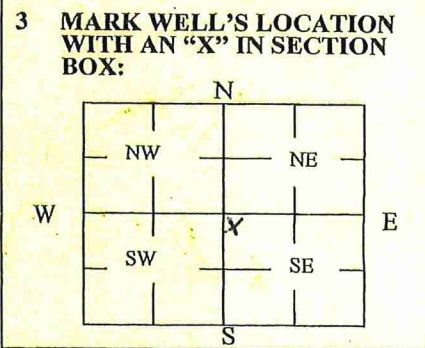

4 DEPTH OF WELL 100 ft. WELL'S STATIC WATER LEVEL 1.3 ft. WELL WAS USED AS:  Domestic  Public Water Supply  Irrigation  Oil Field Water Supply  Feedlot  Domestic (Lawn & Garden)  Industrial  Air Conditioning  Other \_\_\_\_\_ Was a chemical/bacteriological sample submitted to Department? Yes  No

RECEIVED JUL 30 2025 BUREAU OF WATER Dewatering Monitoring Injection Well Other \_\_\_\_\_

5 TYPE OF BLANK CASING USED:  Steel  RMP (SR)  Wrought  Fiberglass  Other (Specify below)  PVC  ABS  Asbestos-Cement  Concrete Tile Blank casing diameter 16 in. Was casing pulled? Yes  No  If yes, how much 56 Casing height above or below land surface 56 in.

6 GROUT PLUG MATERIAL:  Neat cement  Cement grout  Bentonite  Other \_\_\_\_\_ Grout Plug Intervals: From 100 ft. to 159 ft., From 159 ft. to 10 ft., From 10 ft. to 5 ft. What is the nearest source of possible contamination:  Septic tank  Seepage pit  Fuel storage  Other (specify below)  Sewer lines  Pit privy  Fertilizer storage  Watertight sewer lines  Sewage lagoon  Insecticide storage  Lateral lines  Feedyard  Abandoned water well  Oil well/Gas well Direction from well? N E  Cess pool  Livestock pens How many feet? 2900 F

FROM	TO	PLUGGING MATERIALS	FROM	TO	PLUGGING MATERIALS
100	159	Sand			
159	10	Clay Dirt			
10	5	Bentonite			
5	0	Dirt			

7 CONTRACTOR'S OR LANDOWNER'S CERTIFICATION: This water well was plugged under my jurisdiction and was completed on (mo/day/year) 7-22-25 and this record is true to the best of my knowledge and belief. Kansas Water Well Contractor's License No. \_\_\_\_\_ This Water Well Record was completed on (mo/day/year) 7-23-25 under the business name of Jones Construction by (signature) Clay Cluffman

INSTRUCTIONS: Use typewriter or ballpoint pen. Please press firmly and print clearly. Please fill in blanks, underline or circle the correct answers. Send top three copies to Kansas Department of Health and Environment, Bureau of Water, Geology Section, 1000 SW Jackson St., Ste. 420, Topeka, Kansas 66612-1367. Telephone: 785/296-5524. Send one to Water Well Owner and retain one for your records. Visit us at <http://www.kdheks.gov/waterwell/index.html>.