

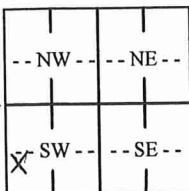
WATER WELL RECORD Form WWC-5

Division of Water
Resources App. No.

IW6

☒ Original Record ☐ Correction ☐ Change in Well Use

Well ID

1 LOCATION OF WATER WELL: County: Cheyenne		Fraction ¼ NW ¼ SW ¼ SW ¼	Section Number 22	Township Number T 3 S	Range Number R 40 ☐ E ☒ W
2 WELL OWNER: Last Name: First: Business: St. Francis Mercantile Equity Exchange Address: 320 W. Washington St. Address: City: St. Francis State: KS ZIP: 67756			Street or Rural Address where well is located (if unknown, distance and direction from nearest town or intersection): If at owner's address, check here: ☒		
3 LOCATE WELL WITH "X" IN SECTION BOX: N  W E S -----1 mile-----	4 DEPTH OF COMPLETED WELL: 23 ft. Depth(s) Groundwater Encountered: 1) 16 ft. 2) ft. 3) ft., or 4) ☐ Dry Well WELL'S STATIC WATER LEVEL: ft. ☐ below land surface, measured on (mo-day-yr)..... ☐ above land surface, measured on (mo-day-yr)..... Pump test data: Well water was ft. after hours pumping gpm Well water was ft. after hours pumping gpm Estimated Yield: gpm Bore Hole Diameter: 8.25 in. to 23 ft. and in. to ft.		5 Latitude: 39.774604 (decimal degrees) Longitude: -101.804906 (decimal degrees) Horizontal Datum: ☒ WGS 84 ☐ NAD 83 ☐ NAD 27 Source for Latitude/Longitude: ☐ GPS (unit make/model:) (WAAS enabled? ☐ Yes ☐ No) ☐ Land Survey ☐ Topographic Map ☒ Online Mapper: Google Earth		
			6 Elevation: 3294 ft. ☒ Ground Level ☐ TOC Source: ☐ Land Survey ☐ GPS ☐ Topographic Map ☒ Other: Google Earth		

7 WELL WATER TO BE USED AS:

- | | | |
|--|--|---|
| 1. Domestic:
☐ Household
☐ Lawn & Garden
☐ Livestock | 5. ☐ Public Water Supply: well ID | 10. ☐ Oil Field Water Supply: lease |
| 2. ☐ Irrigation | 6. ☐ Dewatering: how many wells? | 11. Test Hole: well ID |
| 3. ☐ Feedlot | 7. ☐ Aquifer Recharge: well ID | ☐ Cased ☐ Uncased ☐ Geotechnical |
| 4. ☐ Industrial | 8. ☐ Monitoring: well ID | 12. Geothermal: how many bores? |
| | 9. Environmental Remediation: well ID IW6 | a) Closed Loop ☐ Horizontal ☐ Vertical |
| | ☐ Air Sparge ☐ Soil Vapor Extraction | b) Open Loop ☐ Surface Discharge ☐ Inj. of Water |
| | ☐ Recovery ☒ Injection | 13. ☐ Other (specify): |

Was a chemical/bacteriological sample submitted to KDHE? ☐ Yes ☒ No If yes, date sample was submitted:

Water well disinfected? ☐ Yes ☒ No

8 TYPE OF CASING USED: ☐ Steel ☒ PVC ☐ Other CASING JOINTS: ☐ Glued ☐ Clamped ☐ Welded ☒ Threaded
Casing diameter 2 in. to 21 ft., Diameter in. to ft., Diameter in. to ft.
Casing height above land surface 0 in. Weight lbs./ft. Wall thickness or gauge No. Sch. 40

TYPE OF SCREEN OR PERFORATION MATERIAL:

- ☐ Steel ☐ Stainless Steel ☐ Fiberglass ☒ PVC ☐ Other (Specify)
☐ Brass ☐ Galvanized Steel ☐ Concrete tile ☐ None used (open hole)

SCREEN OR PERFORATION OPENINGS ARE:

- ☐ Continuous Slot ☒ Mill Slot ☐ Gauze Wrapped ☐ Torch Cut ☐ Drilled Holes ☐ Other (Specify)
☐ Louvered Shutter ☐ Key Punched ☐ Wire Wrapped ☐ Saw Cut ☐ None (Open Hole)

SCREEN-PERFORATED INTERVALS: From 21 ft. to 23 ft., From ft. to ft., From ft. to ft.

GRAVEL PACK INTERVALS: From 19 ft. to 23 ft., From ft. to ft., From ft. to ft.

9 GROUT MATERIAL: ☐ Neat cement ☐ Cement grout ☒ Bentonite ☐ Other

Grout Intervals: From 3.5 ft. to 19 ft., From ft. to ft., From ft. to ft.

Nearest source of possible contamination:

- | | | | | |
|---|--|--|---|---|
| ☐ Septic Tank | ☐ Lateral Lines | ☐ Pit Privy | ☐ Livestock Pens | ☐ Insecticide Storage |
| ☐ Sewer Lines | ☐ Cess Pool | ☐ Sewage Lagoon | ☐ Fuel Storage | ☐ Abandoned Water Well |
| ☐ Watertight Sewer Lines | ☐ Seepage Pit | ☐ Feedyard | ☐ Fertilizer Storage | ☐ Oil Well/Gas Well |

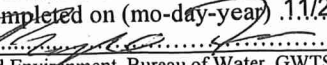
☐ Other (Specify)

Direction from well? Distance from well? ft.

10 FROM	TO	LITHOLOGIC LOG	FROM	TO	LITHO. LOG (cont.) or PLUGGING INTERVALS
0	0.5	Sand and Gravel			
0.5	8	Sand, vf-m, sl. silty, Dk Brn to Brn			
8	12	Silt, sandy from 10-12', Brown			
12	16	Sand, f-c, w/slty strngs, Gray, sbdr-rd			
16	19	Sand, f-c w/f gravel, Gy Brn to Brn, sat.			
19	23	Sand, f-c w/f gravel, clayey strngs, Brn			

Notes:

BUREAU OF WATER

11 CONTRACTOR'S OR LANDOWNER'S CERTIFICATION: This water well was ☒ constructed, ☐ reconstructed, or ☐ plugged under my jurisdiction and was completed on (mo-day-year) 10/30/2025 and this record is true to the best of my knowledge and belief. Kansas Water Well Contractor's License No. 527 This Water Well Record was completed on (mo-day-year) 11/25/2025 under the business name of GeoCore, LLC Signature: 

Mail 1 white copy along with a fee of \$5.00 for each constructed well to: Kansas Department of Health and Environment, Bureau of Water, GWTS Section, 1000 SW Jackson St., Suite 420, Topeka, Kansas 66612-1367. Mail one to Water Well Owner and retain one for your records. Telephone 785-296-5524.

Visit us at <http://www.kdheks.gov/waterwell/index.html>

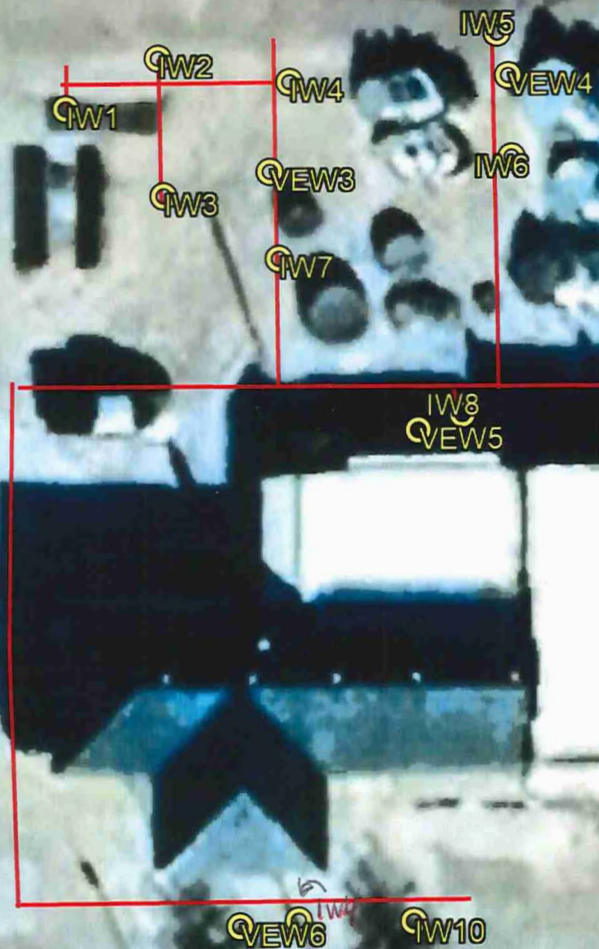
KSA 82a-1212

Revised 7/10/2015

RECEIVED

DEC 24 2025

BUREAU OF WATER




St. Francis Mercantile Equity Exchange
320 W Washington, St. Francis KS
KDE # 46-012-14962

T.3 R.40W Sec.22

Cheyenne County

Google Earth

Image © 2025 Airbus

100 ft

