

**WATER WELL PLUGGING RECORD Form WWC-5P KSA 82a-1212 ID NO.**  

**1 LOCATION OF WATER WELL:** Fraction NW 1/4 SW 1/4 NE 1/4 NW 1/4 Section Number 27 Township Number T 24 S Range Number 32  E  W  
 County: Finney


Street/Rural Address of Well Location; if unknown, distance & direction from nearest town or intersection: If at owner's address, check here  1 Mile SE of Garden City, KS

**Global Positioning Systems (GPS) information:**  
 Latitude: 37.943877 (in decimal degrees)  
 Longitude: -100.824150 (in decimal degrees)  
 Elevation: 2843'  
 Horizontal Datum:  WGS84,  NAD83,  NAD27  
 Collection Method: \_\_\_\_\_

**2 WATER WELL OWNER:** Damme Partnership  
 RR#, St. Address, Box #: PO Box 1611  
 City, State ZIP Code: Garden City, KS 67846

GPS unit (Make/Model: \_\_\_\_\_)  
 Digital Map/Photo,  Topographic Map,  Land Survey  
 Est. Accuracy:  < 3 m,  3-5 m,  5-15 m,  > 15 m

**3 MARK WELL'S LOCATION WITH AN "X" IN SECTION BOX:**

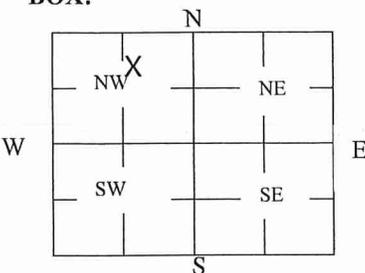

**4 DEPTH OF WELL** 204 ft.  
 WELL'S STATIC WATER LEVEL 197 ft.  
 WELL WAS USED AS:

Domestic  Public Water Supply  Dewatering  
 Irrigation  Oil Field Water Supply  Monitoring  
 Feedlot  Domestic (Lawn & Garden)  Injection Well  
 Industrial  Air Conditioning  Other \_\_\_\_\_

Was a chemical/bacteriological sample submitted to Department? Yes  No

**5 TYPE OF BLANK CASING USED:**

Steel  RMP (SR)  Wrought  Fiberglass  Other (Specify below)  
 PVC  ABS  Asbestos-Cement  Concrete Tile Plugged

Blank casing diameter 16 in. Was casing pulled? Yes  No  If yes, how much 7'  
 Casing height above or below land surface 84 in.

**6 GROUT PLUG MATERIAL:**  Neat cement  Cement grout  Bentonite  Other \_\_\_\_\_

Grout Plug Intervals: From 189 ft. to 196 ft., From 196 ft. to 197 ft., From \_\_\_\_\_ ft. to \_\_\_\_\_ ft.

What is the nearest source of possible contamination:

Septic tank  Seepage pit  Fuel storage  Other (specify below)  
 Sewer lines  Pit privy  Fertilizer storage Irrigation Well  
 Watertight sewer lines  Sewage lagoon  Insecticide storage \_\_\_\_\_  
 Lateral lines  Feedyard  Abandoned water well Direction from well? South  
 Cess pool  Livestock pens  Oil well/Gas well How many feet? 292'

FROM	TO	PLUGGING MATERIALS	FROM	TO	PLUGGING MATERIALS
0	1	Concrete			
1	8	Bentonite			
8	189	Clay Material			
189	204	Gravel Sand			

RECEIVED

JAN 23 2026

BUREAU OF WATER

**7 CONTRACTOR'S OR LANDOWNER'S CERTIFICATION:** This water well was plugged under my jurisdiction and was completed on (mo/day/year) 01/07/2026 and this record is true to the best of my knowledge and belief. Kansas Water Well Contractor's License No. \_\_\_\_\_. This Water Well Record was completed on (mo/day/year) 01/09/2026 under the business name of AimX Irrigation Solutions, Inc by (signature) \_\_\_\_\_