WATER WELL PLUGGING RECORD Form WWC-5P KSA 82a-1212 ID NO.

1 LOCATION OF WATER WELL: County: Meade | Fraction: ¼ SE ¼ SE ¼ NE ¼ | Section Number: 25 | Township Number: T 30 S | Range Number: 29 ☐ E ☒ W

Street/Rural Address of Well Location; if unknown, distance & direction from nearest town or intersection: If at owner's address, check here ☐
From 13rd and E rd, 2350 ft South and 185 ft west.

Global Positioning Systems (GPS) information:
Latitude: 37.409 9176 (in decimal degrees)
Longitude: -100.434 5381 (in decimal degrees)
Elevation: 2733
Horizontal Datum: ☐ WGS84, ☐ NAD83, ☐ NAD27
Collection Method:
☐ GPS unit (Make/Model:) ☐ Digital Map/Photo. ☐ Topographic Map. ☐ Land Survey
Est. Accuracy: ☐ < 3 m. ☐ 3-5 m. ☐ 5-15 m. ☐ > 15 m

2 WATER WELL OWNER: Merle + Marilyn Rexford
RR#, St. Address, Box #: C/O Terry Cordes P.O. 1270
City, State ZIP Code: Meade, KS 67864

3 MARK WELL'S LOCATION WITH AN "X" IN SECTION BOX:

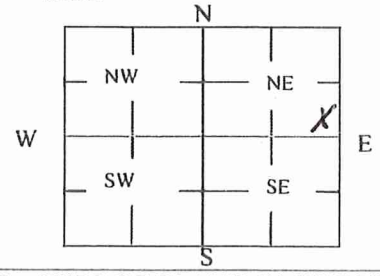

4 DEPTH OF WELL 190 ft.
WELL'S STATIC WATER LEVEL Dry ft
WELL WAS USED AS:
☒ Domestic ☐ Irrigation ☐ Feedlot ☐ Industrial
☐ Public Water Supply ☐ Oil Field Water Supply ☐ Domestic (Lawn & Garden) ☐ Air Conditioning
☐ Dewatering ☐ Monitoring ☐ Injection Well ☐ Other
Was a chemical/bacteriological sample submitted to Department? Yes ☐ No ☒

5 TYPE OF BLANK CASING USED:
☒ Steel ☐ PVC ☐ RMP (SR) ☐ ABS ☐ Wrought ☐ Asbestos-Cement ☐ Fiberglass ☐ Concrete Tile ☐ Other (Specify below)

RECEIVED
MAR 16 2026
BUREAU OF WATER

Blank casing diameter 4.5 in. Was casing pulled? Yes ☐ No ☒ If yes, how much
Casing height above or below land surface 60 in.

6 GROUT PLUG MATERIAL: ☐ Neat cement ☐ Cement grout ☒ Bentonite ☐ Other

Grout Plug Intervals: From 6 ft. to 4 ft., From ft. to ft., From ft. to ft.

What is the nearest source of possible contamination:
☐ Septic tank ☐ Sewer lines ☐ Watertight sewer lines ☐ Lateral lines ☐ Cess pool
☐ Seepage pit ☐ Pit privy ☐ Sewage lagoon ☐ Feedyard ☐ Livestock pens
☐ Fuel storage ☐ Fertilizer storage ☐ Insecticide storage ☐ Abandoned water well ☐ Oil well/Gas well
☑ Other (specify below) Domestic water well
Direction from well? South
How many feet? 900

FROM	TO	PLUGGING MATERIALS	FROM	TO	PLUGGING MATERIALS
190	6	Clay			
6	4	Bentonite			

7 CONTRACTOR'S OR LANDOWNER'S CERTIFICATION: This water well was plugged under my jurisdiction and was completed on (mo/day/year) 3/5/26 and this record is true to the best of my knowledge and belief. Kansas Water Well Contractor's License No. This Water Well Record was completed on (mo/day/year) 3/5/26 under the business name of Smith Irrigation Inc by (signature)

Send one white copy to Kansas Department of Health & Environment, Geology Section, 1000 SW Jackson Street, Ste. 420, Topeka, KS 66612-1367. Send one copy to WATER WELL OWNER and retain one for your records.
Visit us at http://www.kdheks.gov/waterwell/index.html Telephone 785-296-5524.