WATER WELL RECORD Form WWC-5

■ Original Record ☐ Correction ☐ Change in Well Use

Division of Water Resources App. No. _____ Well ID MW-46BR

1 LOCATION OF WATER WELL: County: Johnson | Fraction: SE ¼ SE ¼ NW ¼ ¼ | Section Number: 36 | Township Number: T 13 S | Range Number: R 23 ■ E ☐ W

2 WELL OWNER: Last Name: First:
Business: The Boeing Company
Address: 2727 E MacArthur
Address:
City: Wichita State: KS ZIP: 67216

Street or Rural Address where well is located (if unknown, distance and direction from nearest town or intersection): If at owner's address, check here: ☐
On S. Keeler St. Approximately 515 ft South from the intersection of S. Keeler St. and E. Cedar St.

3 LOCATE WELL WITH "X" IN SECTION BOX:
N / W / E / S; NW, NE, SW, SE; X in NW
|---------1 mile---------|

4 DEPTH OF COMPLETED WELL: 23 ft.
Depth(s) Groundwater Encountered: 1) ..... ft. 2) ..... ft. 3) ..... ft., or 4) ☐ Dry Well
WELL'S STATIC WATER LEVEL: 14.29 ft.
■ below land surface, measured on (mo-day-yr) 11/20/2025
☐ above land surface, measured on (mo-day-yr).....
Pump test data: Well water was ..... ft. after ..... hours pumping ..... gpm
Well water was ..... ft. after ..... hours pumping ..... gpm
Estimated Yield: .....gpm
Bore Hole Diameter: 10.75 in. to 17.5 ft. and 6.1 in. to 23 ft.

5 Latitude: 38.87776944 (decimal degrees)
Longitude: -94.80599444 (decimal degrees)
Horizontal Datum: ☐ WGS 84 ■ NAD 83 ☐ NAD 27
Source for Latitude/Longitude:
☐ GPS (unit make/model: .....)
(WAAS enabled? ☐ Yes ☐ No)
■ Land Survey ☐ Topographic Map
☐ Online Mapper: .....

6 Elevation: 1051.41 ft. ■ Ground Level ☐ TOC
Source: ■ Land Survey ☐ GPS ☐ Topographic Map ☐ Other .....

7 WELL WATER TO BE USED AS:
1. Domestic: ☐ Household ☐ Lawn & Garden ☐ Livestock
2. ☐ Irrigation
3. ☐ Feedlot
4. ☐ Industrial
5. ☐ Public Water Supply: well ID .....
6. ☐ Dewatering: how many wells? .....
7. ☐ Aquifer Recharge: well ID .....
8. ■ Monitoring: well ID MW-46BR
9. Environmental Remediation: well ID ..... ☐ Air Sparge ☐ Soil Vapor Extraction ☐ Recovery ☐ Injection
10. ☐ Oil Field Water Supply: lease .....
11. Test Hole: well ID ..... ☐ Cased ☐ Uncased ☐ Geotechnical
12. Geothermal: how many bores? ..... a) Closed Loop ☐ Horizontal ☐ Vertical b) Open Loop ☐ Surface Discharge ☐ Inj. of Water
13. ☐ Other (specify): .....

Was a chemical/bacteriological sample submitted to KDHE? ☐ Yes ■ No If yes, date sample was submitted: .....
Water well disinfected? ☐ Yes ■ No

8 TYPE OF CASING USED: ☐ Steel ■ PVC ☐ Other ..... CASING JOINTS: ☐ Glued ☐ Clamped ☐ Welded ■ Threaded
Casing diameter 2 in. to 18 ft., Diameter 6.625 in. to 17.5 ft., Diameter ..... in. to ..... ft.
Casing height above land surface ~4 in. Weight ..... lbs./ft. Wall thickness or gauge No. Sch 40
TYPE OF SCREEN OR PERFORATION MATERIAL:
☐ Steel ☐ Stainless Steel ☐ Fiberglass ■ PVC ☐ Other (Specify) .....
☐ Brass ☐ Galvanized Steel ☐ Concrete tile ☐ None used (open hole)
SCREEN OR PERFORATION OPENINGS ARE:
☐ Continuous Slot ■ Mill Slot ☐ Gauze Wrapped ☐ Torch Cut ☐ Drilled Holes ☐ Other (Specify) .....
☐ Louvered Shutter ☐ Key Punched ☐ Wire Wrapped ☐ Saw Cut ☐ None (Open Hole)
SCREEN-PERFORATED INTERVALS: From 18 ft. to 23 ft., From ..... ft. to ..... ft., From ..... ft. to ..... ft.
GRAVEL PACK INTERVALS: From 17.5 ft. to 23 ft., From ..... ft. to ..... ft., From ..... ft. to ..... ft.

9 GROUT MATERIAL: ☐ Neat cement ■ Cement grout ■ Bentonite ☐ Other .....
Grout Intervals: From 0 ft. to 14.5 ft., From 14.5 ft. to 17.5 ft., From ..... ft. to ..... ft.
Nearest source of possible contamination:
☐ Septic Tank ☐ Lateral Lines ☐ Pit Privy ☐ Livestock Pens ☐ Insecticide Storage
☐ Sewer Lines ☐ Cess Pool ☐ Sewage Lagoon ☐ Fuel Storage ☐ Abandoned Water Well
☐ Watertight Sewer Lines ☐ Seepage Pit ☐ Feedyard ☐ Fertilizer Storage ☐ Oil Well/Gas Well
■ Other (Specify) Former Chemical Commodities, Inc. Site .....
Direction from well? NE Distance from well? ~320 ft.

10 FROM	TO	LITHOLOGIC LOG	FROM	TO	LITHO. LOG (cont.) or PLUGGING INTERVALS
0	5.5	Hydrovac for utility clearance			
5.5	14.3	Silty Clay			
14.3	15.5	Weathered Rock, Silty clay, trace gravel			
15.5	17.5	Limestone			
17.5	20	Sandy Limestone with Sandstone			
20	22	Fine grained Sandstone			
22	24	Slightly weathered Shale			

Notes:

RECEIVED
DEC 29 2025
BUREAU OF WATER

11 CONTRACTOR'S OR LANDOWNER'S CERTIFICATION: This water well was ■ constructed, ☐ reconstructed, or ☐ plugged under my jurisdiction and was completed on (mo-day-year) 11/25/2025 and this record is true to the best of my knowledge and belief. Kansas Water Well Contractor's License No. 1031 This Water Well Record was completed on (mo-day-year) 12/19/2025 under the business name of Environmental Works, Inc. Signature *Daniel Yoakum*

Mail 1 white copy along with a fee of $5.00 for each constructed well to: Kansas Department of Health and Environment, Bureau of Water, GWTS Section, 1000 SW Jackson St., Suite 420, Topeka, Kansas 66612-1367. Mail one to Water Well Owner and retain one for your records. Telephone 785-296-5524.

Visit us at http://www.kdheks.gov/waterwell/index.html KSA 82a-1212 **Revised 7/10/2015**

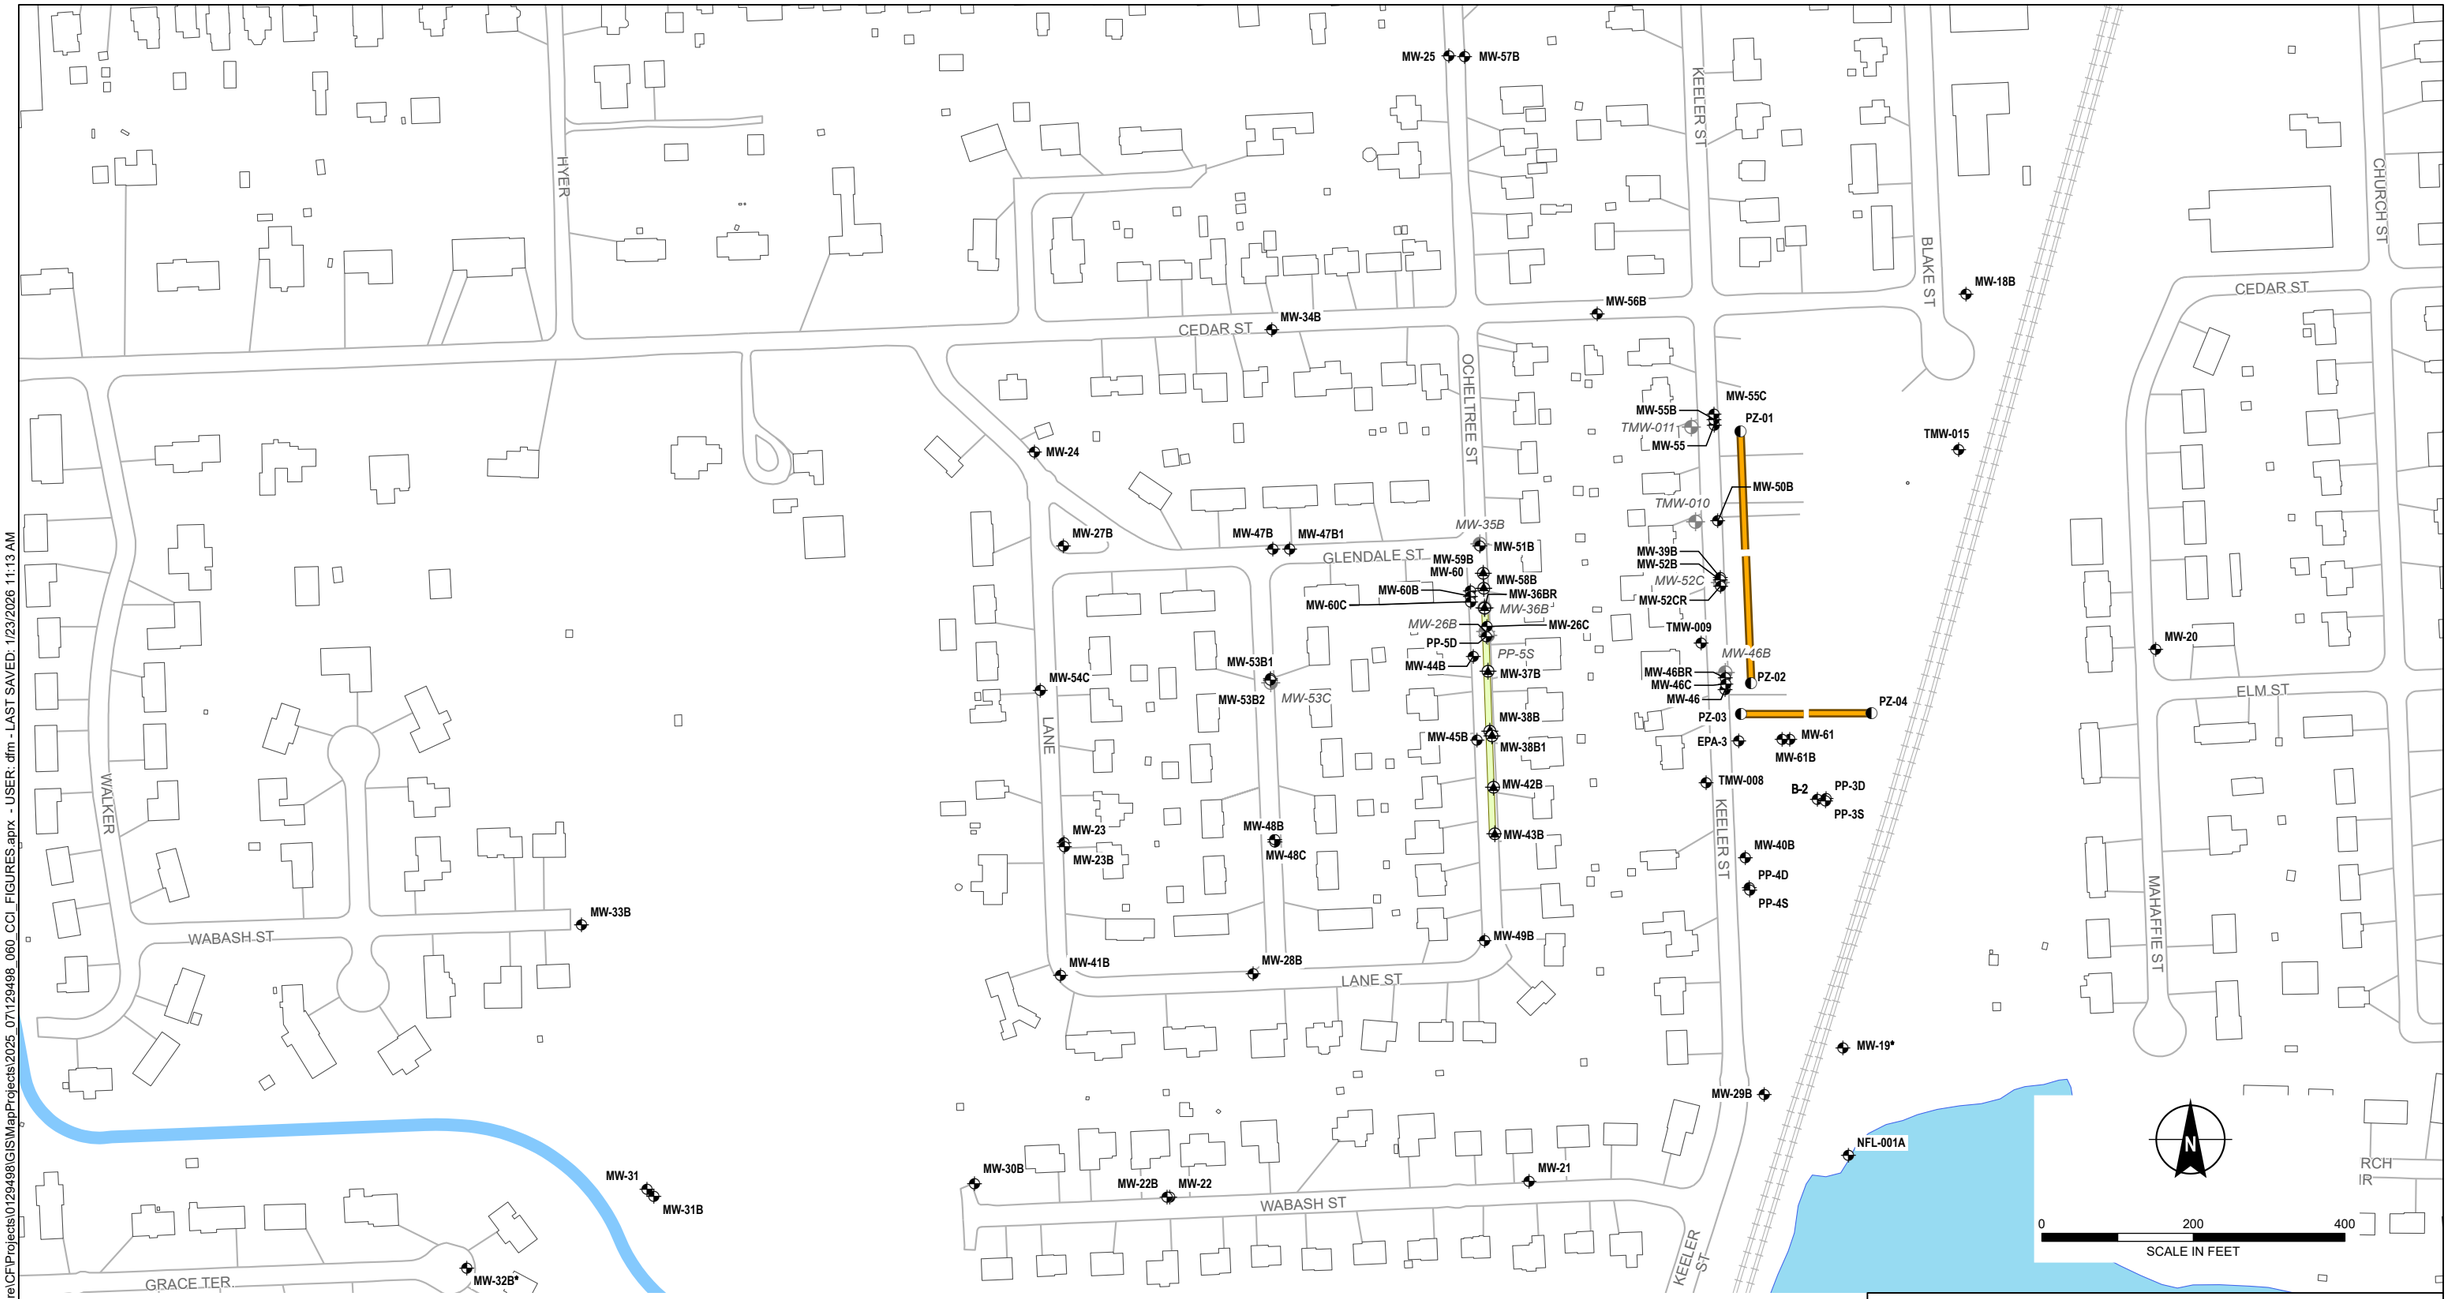

LEGEND

- MONITORING WELL
- PIEZOMETER
- INJECTION WELL
- ABANDONED MONITORING WELL
- RESIDENCE
- Chemical Oxidation Trench Location
- OFF-SITE CHEMICAL OXIDATION DELIVERY SYSTEM LOCATION
- RAILROAD TRACKS

NOTES:

1. ALL LOCATIONS AND DIMENSIONS ARE APPROXIMATE.
2. * - UNABLE TO LOCATE WELL IN 2026

HALEY ALDRICH

CHEMICAL COMMODITIES, INC.
OLATHE, KANSAS

WELL LOCATIONS

JANUARY 2026

FIGURE

GIS FILE PATH: \\haleyaldrich.com\share\CF\Projects\0129498\GIS\MapProjects\2025_07\129498_060_CCI_FIGURES.aprx - USER: dfm - LAST SAVED: 1/23/2026 11:13 AM