

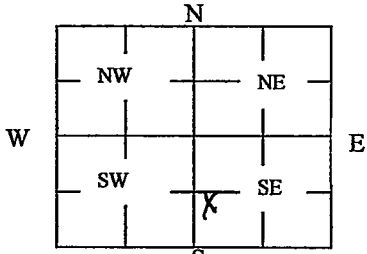
WATER WELL PLUGGING RECORD Form WWC-5P

KSA 82a-1212

ID NO.

MW4

1 LOCATION OF WATER WELL: County: Reno	Fraction NW ¼ SW ¼ SE ¼ ¼	Section Number 25	Township Number T 23 S	Range Number 6 E W
Street/Rural Address of Well Location; if unknown, distance & direction from nearest town or intersection: If at owner's address, check here ☒ 719ft Northwest from the point where Williams Ave. ends and the pavement stops. South Hutchinson		Global Positioning Systems (GPS) information: Latitude: 38.01667 (in decimal degrees) Longitude: -97.930556 (in decimal degrees) Elevation: 1530 Horizontal Datum: ☒ WGS84, ☐ NAD83, ☐ NAD27 Collection Method: ☒ GPS unit (Make/Model: Apple iPhone 15) ☐ Digital Map/Photo, ☐ Topographic Map, ☐ Land Survey Est. Accuracy: ☒ < 3 m, ☐ 3-5 m, ☐ 5-15 m, ☐ > 15 m		
2 WATER WELL OWNER: KDHE RR#, St. Address, Box #: 1000 SE Jackson, Suite 410 City, State ZIP Code: Topeka, KS. 66612-1367				

3 MARK WELL'S LOCATION WITH AN "X" IN SECTION BOX: 	4 DEPTH OF WELL 23 ft. WELL'S STATIC WATER LEVEL 14 ft. WELL WAS USED AS: ☐ Domestic ☐ Public Water Supply ☐ Dewatering ☐ Irrigation ☐ Oil Field Water Supply ☐ Monitoring ☐ Feedlot ☐ Domestic (Lawn & Garden) ☐ Injection Well ☐ Industrial ☐ Air Conditioning ☐ Other _____ Was a chemical/bacteriological sample submitted to Department? Yes ☐ No ☒
--	---

5 TYPE OF BLANK CASING USED:

☐ Steel ☐ RMP (SR) ☐ Wrought ☐ Fiberglass ☐ Other (Specify below)
☒ PVC ☐ ABS ☐ Asbestos-Cement ☐ Concrete Tile

Blank casing diameter 2 in. Was casing pulled? Yes ☒ No ☐ If yes, how much 36"

Casing height above or below and surface 36 in.

6 GROUT PLUG MATERIAL: ☐ Neat cement ☐ Cement grout ☒ Bentonite ☐ Other _____

Grout Plug Intervals: From 0 ft. to 23 ft., From _____ ft. to _____ ft., From _____ ft. to _____ ft.

What is the nearest source of possible contamination:

☐ Septic tank	☐ Seepage pit	☐ Fuel storage	☒ Other (specify below) Railroad Tracks Direction from well? West How many feet? 15
☐ Sewer lines	☐ Pit privy	☐ Fertilizer storage	
☐ Watertight sewer lines	☐ Sewage lagoon	☐ Insecticide storage	
☐ Lateral lines	☐ Feedyard	☐ Abandoned water well	
☐ Cess pool	☐ Livestock pens	☐ Oil well/Gas well	

FROM	TO	PLUGGING MATERIALS	FROM	TO	PLUGGING MATERIALS
0	23ft	Sodium bentonite with chlorinated water			

7 CONTRACTOR'S OR LANDOWNER'S CERTIFICATION: This water well was plugged under my jurisdiction and was completed on (mo/day/year) 10/20/25 and this record is true to the best of my knowledge and belief. Kansas Water Well Contractor's License No. 913. This Water Well Record was completed on (mo/day/year) 10/31/2025 under the business name of Flint Hills Windmill and Well Pump Service, LLC by (signature) Tod Jones

Send one white copy to Kansas Department of Health & Environment, Geology Section, 1000 SW Jackson Street, Ste. 420, Topeka, KS 66612-1367. Send one copy to WATER WELL OWNER and retain one for your records.
 Visit us at <http://www.kdheks.gov/waterwell/index.html> Telephone 785-296-5524.

KSA82a-1212

Revised 1/20/2015
RECEIVED

NOV 07 2025

BUREAU OF WATER