


WATER WELL PLUGGING RECORD Form WWC-5P

KSA 82a-1212

ID NO.

S-34

1 LOCATION OF WATER WELL: County: Sedgwick	Fraction SW ¼ SE ¼ NW ¼ SE ¼	Section Number 19	Township Number T 27 S	Range Number 2 ☒ E ☐ W
Street/Rural Address of Well Location; if unknown, distance & direction from nearest town or intersection: If at owner's address, check here ☐ 3 Feet East and 199 Feet South of the SW Corner of Top Insurance Agency, 7700 East Kellogg, Wichita, KS		Global Positioning Systems (GPS) information: Latitude: N 37.683649310 (in decimal degrees) Longitude: W 97.250240645 (in decimal degrees) Elevation: 1346 Horizontal Datum: ☒ WGS84, ☐ NAD83, ☐ NAD27 Collection Method: ☐ GPS unit (Make/Model: _____) ☐ Digital Map/Photo, ☐ Topographic Map, ☒ Land Survey Est. Accuracy: ☒ < 3 m, ☐ 3-5 m, ☐ 5-15 m, ☐ > 15 m		
2 WATER WELL OWNER: Towne East Joint Venture RR#, St. Address, Box #: 115 West Washington Street City, State ZIP Code: Indianapolis, IN 46204				

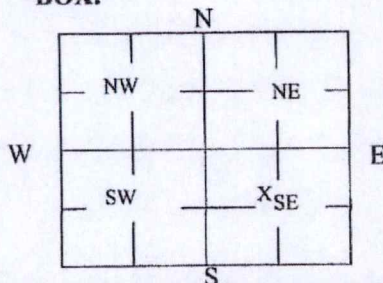3 MARK WELL'S LOCATION WITH AN "X" IN SECTION BOX:**4 DEPTH OF WELL** 13 **ft.**WELL'S STATIC WATER LEVEL 8.02 **ft**

WELL WAS USED AS:

- ☐
- Domestic
-
- ☐
- Irrigation
-
- ☐
- Feedlot
-
- ☐
- Industrial

- ☐
- Public Water Supply
-
- ☐
- Oil Field Water Supply
-
- ☐
- Domestic (Lawn & Garden)
-
- ☐
- Air Conditioning

- ☐
- Dewatering
-
- ☒
- Monitoring
-
- ☐
- Injection Well
-
- ☐
- Other _____

Was a chemical/bacteriological sample submitted to Department? Yes ☐ No ☐**5 TYPE OF BLANK CASING USED:**
☐ Steel
☒ PVC

☐ RMP (SR)
☐ ABS

☐ Wrought
☐ Asbestos-Cement

☐ Fiberglass
☐ Concrete Tile
☐ Other (Specify below) _____
 Blank casing diameter 2 in. Was casing pulled? Yes ☒ No ☐ If yes, how much 13ft
 Casing height above or below land surface 0 in.
6 GROUT PLUG MATERIAL:☒ Neat cement☐ Cement grout☐ Bentonite☐ Other _____

Grout Plug Intervals: From 0 ft. to 13 ft., From _____ ft. to _____ ft., From _____ ft. to _____ ft.

What is the nearest source of possible contamination:

- ☐
- Septic tank
-
- ☐
- Sewer lines
-
- ☐
- Watertight sewer lines
-
- ☐
- Lateral lines
-
- ☐
- Cess pool

- ☐
- Seepage pit
-
- ☐
- Pit privy
-
- ☐
- Sewage lagoon
-
- ☐
- Feedyard
-
- ☐
- Livestock pens

- ☒
- Fuel storage
-
- ☐
- Fertilizer storage
-
- ☐
- Insecticide storage
-
- ☐
- Abandoned water well
-
- ☐
- Oil well/Gas well

☐ Other (specify below) _____

Direction from well? _____

How many feet? _____

FROM	TO	PLUGGING MATERIALS	FROM	TO	PLUGGING MATERIALS
0	0.5	Asphalt			
0.5	3	Clean compacted soil			
3	13	Neat Cement			

RECEIVED

JUN 13 2025

BUREAU OF WATER


7 CONTRACTOR'S OR LANDOWNER'S CERTIFICATION: This water well was plugged under my jurisdiction and was completed on (mo/day/year) 10/17/24 and this record is true to the best of my knowledge and belief. Kansas Water Well Contractor's License No. 604. This Water Well Record was completed on (mo/day/year) 6/10/25 under the business name of Environmental Priority Service, Inc. by (signature) [Signature]

Send one white copy to Kansas Department of Health & Environment, Geology Section, 1000 SW Jackson Street, Ste. 420, Topeka, KS 66612-1367. Send one copy to WATER WELL OWNER and retain one for your records.

 Visit us at <http://www.kdheks.gov/waterwell/index.html> Telephone 785-296-5524.

KSA82a-1212

Revised 1/20/2015

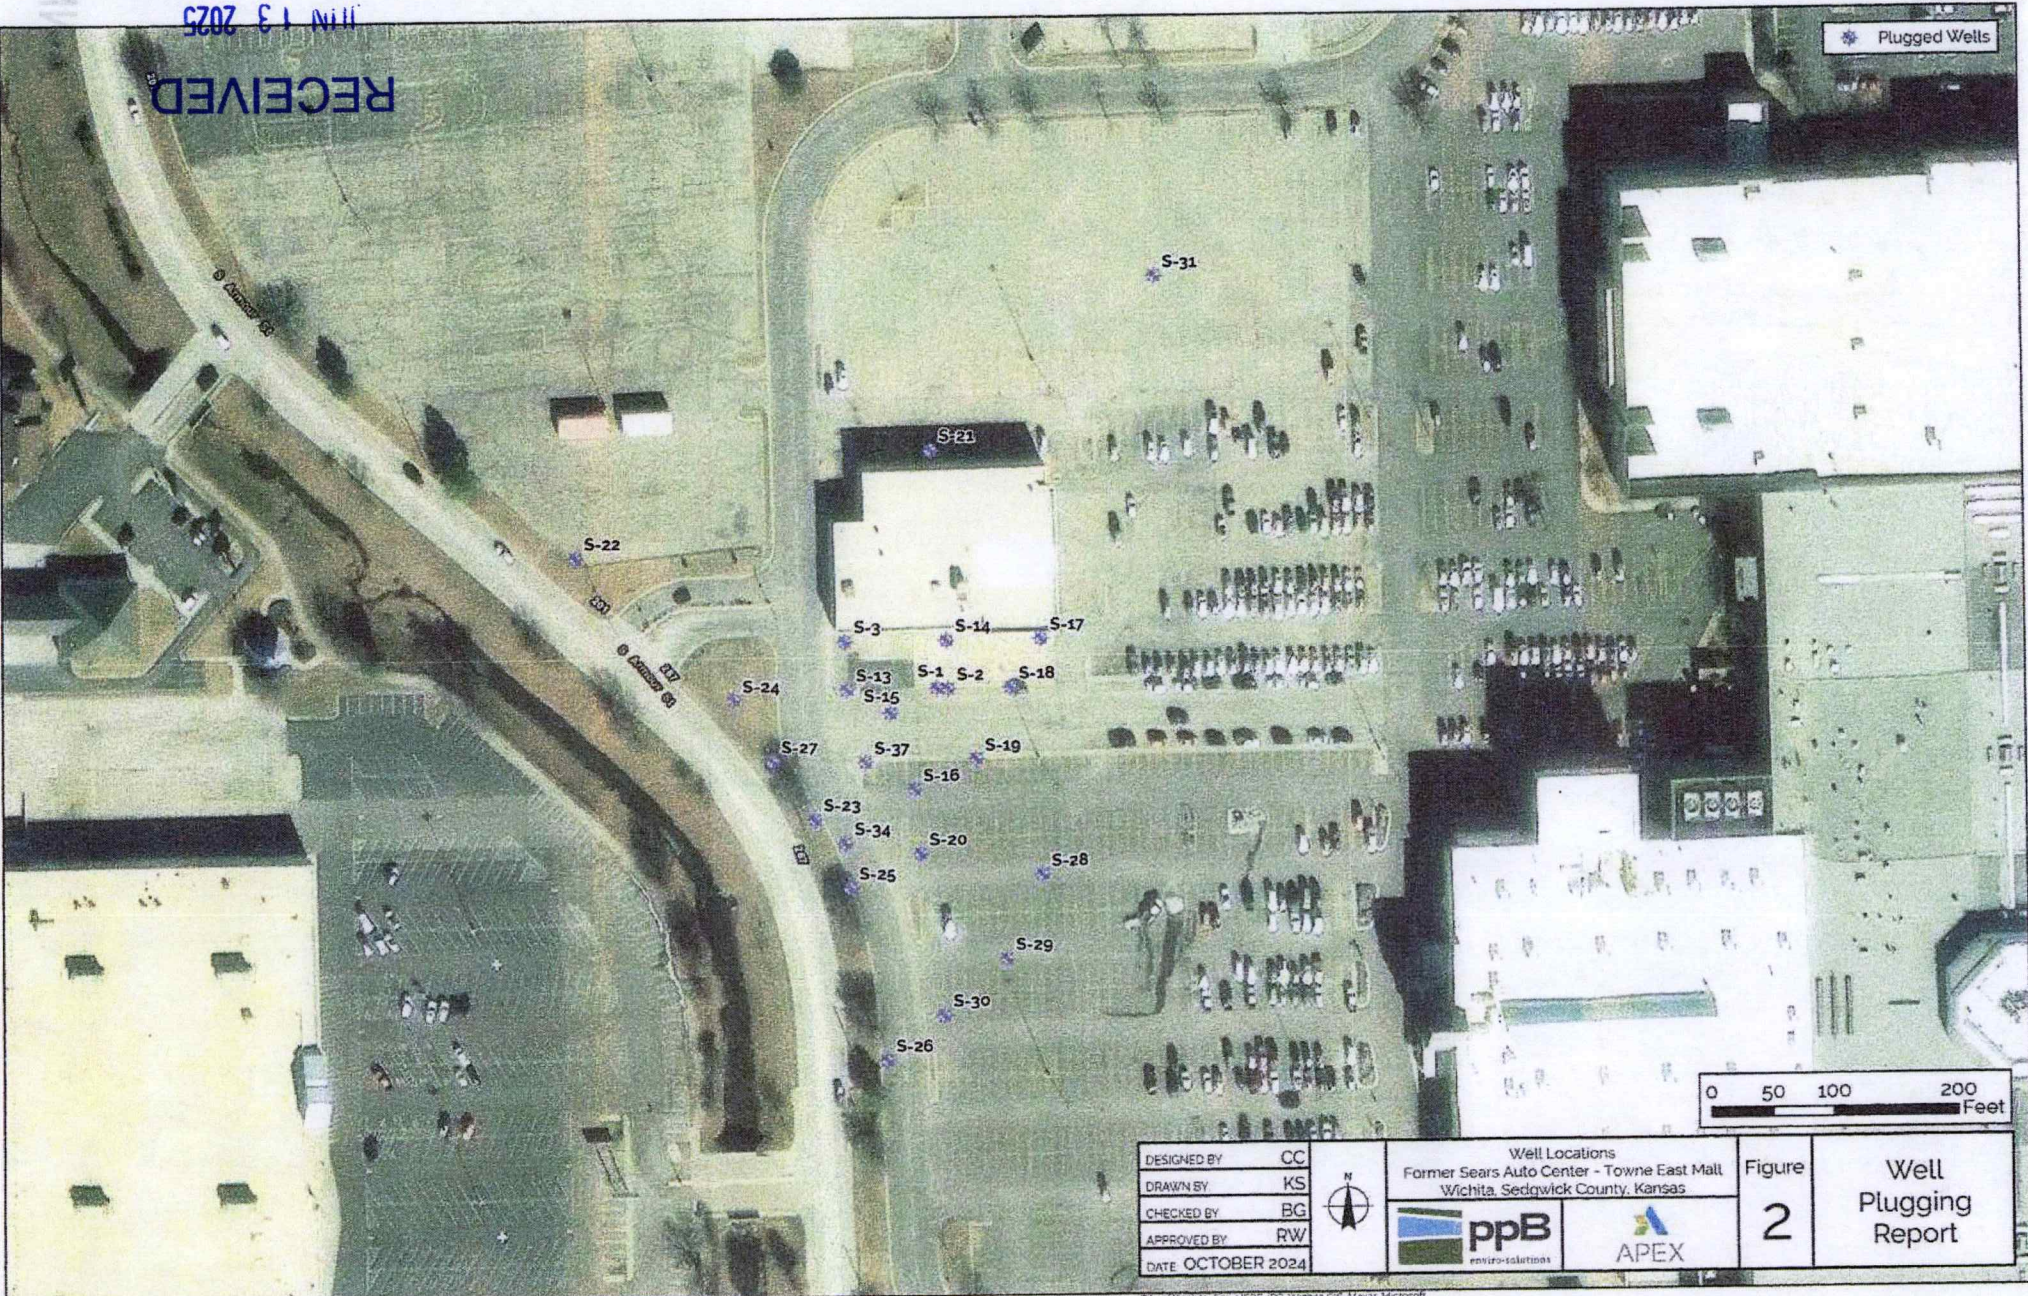

DESIGNED BY	CC		Well Locations		Figure	Well Plugging Report
DRAWN BY	KS		Former Sears Auto Center - Towne East Mall			
CHECKED BY	BG		Wichita, Sedgwick County, Kansas			
APPROVED BY	RW					
DATE	OCTOBER 2024					
		