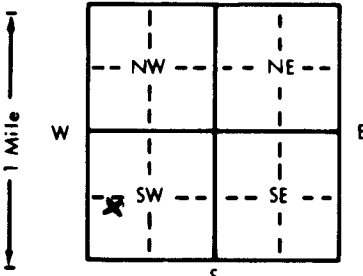


1 LOCATION OF WATER WELL: County: Clay	Fraction: SW 1/4 SW 1/4 SW 1/4	Section Number: 10	Township Number: T 10 S	Range Number: R 1 E/W
---	---------------------------------------	---------------------------	--------------------------------	------------------------------

Distance and direction from nearest town or city street address of well if located within city?

One mile east + 1 1/4 mile North of Langford, KS

2 WATER WELL OWNER: Earl C Herman RR#, St. Address, Box #: P.O. Box 353 City, State, ZIP Code: Wakefield KS 67487	Board of Agriculture, Division of Water Resources Application Number:
--	--

3 LOCATE WELL'S LOCATION WITH AN "X" IN SECTION BOX:	4 DEPTH OF COMPLETED WELL: 28 ft. ELEVATION:
	Depth(s) Groundwater Encountered 1. 10.5 ft. 2. ft. 3. ft.
	WELL'S STATIC WATER LEVEL 10.5 ft. below land surface measured on mo/day/yr Pump test data: Well water was ft. after hours pumping gpm Est. Yield gpm: Well water was ft. after hours pumping gpm Bore Hole Diameter in. to ft., and in. to ft.
	WELL WATER TO BE USED AS: 5 Public water supply 8 Air conditioning 11 Injection well <u>1 Domestic</u> 3 Feedlot 6 Oil field water supply 9 Dewatering 12 Other (Specify below) 2 Irrigation 4 Industrial 7 Lawn and garden only 10 Monitoring well
	Was a chemical/bacteriological sample submitted to Department? Yes No <u>X</u> If yes, mo/day/yr sample was submitted Water Well Disinfected? Yes <u>X</u> No

5 TYPE OF BLANK CASING USED:	5 Wrought iron	8 Concrete tile	CASING JOINTS: Glued Clamped
1 Steel	3 RMP (SR)	6 Asbestos-Cement	9 Other (specify below)
2 PVC	4 ABS	7 Fiberglass	Welded
Blank casing diameter 4.5 in. to ft., Dia in. to ft., Dia in. to ft.			Threaded
Casing height NO above land surface in., weight lbs./ft. Wall thickness or gauge No.			
TYPE OF SCREEN OR PERFORATION MATERIAL:	7 PVC	10 Asbestos-cement	
1 Steel	3 Stainless steel	5 Fiberglass	8 RMP (SR)
2 Brass	4 Galvanized steel	6 Concrete tile	9 ABS
SCREEN OR PERFORATION OPENINGS ARE:	5 Gauzed wrapped	8 Saw cut	11 None (open hole)
1 Continuous slot	3 Mill slot	6 Wire wrapped	9 Drilled holes
2 Louvered shutter	4 Key punched	7 Torch cut	10 Other (specify) NA
SCREEN-PERFORATED INTERVALS: From NA ft. to NA ft., From ft. to ft.			
GRAVEL PACK INTERVALS: From ft. to ft., From ft. to ft.			

6 GROUT MATERIAL: 1 Neat cement 4 Other	2 Cement grout	3 Bentonite	4 Other
Grout Intervals: From 4.5 ft. to 4 ft., From ft. to ft., From ft. to ft.			
What is the nearest source of possible contamination:	7 Pit privy	10 Livestock pens	14 Abandoned water well
1 Septic tank	4 Lateral lines	11 Fuel storage	15 Oil well/Gas well
2 Sewer lines	5 Cess pool	12 Fertilizer storage	16 Other (specify below)
3 Watertight sewer lines	6 Seepage pit	13 Insecticide storage	NONE APPARENT
Direction from well?	How many feet?		

FROM	TO	LITHOLOGIC LOG	FROM	TO	PLUGGING INTERVALS
			28	10.5	Sand
			10.5	4.5	Subsoil
			4.5	4.0	Bentonite
			4.0	0	Topsoil

7 CONTRACTOR'S OR LANDOWNER'S CERTIFICATION: This water well was (1) constructed, (2) reconstructed, or (3) plugged under my jurisdiction and was completed on (mo/day/year) and this record is true to the best of my knowledge and belief. Kansas Water Well Contractor's License No. This Water Well Record was completed on (mo/day/yr) 11/10/93 under the business name of by (signature) <u>Earl C Herman</u>
--

INSTRUCTIONS: Use typewriter or ball point pen. PLEASE PRESS FIRMLY and PRINT clearly. Please fill in blanks, underline or circle the correct answers. Send top three copies to Kansas Department of Health and Environment, Bureau of Water, Topeka, Kansas 66620-0001. Telephone: 913-296-5545. Send one to WATER WELL OWNER and retain one for your records.