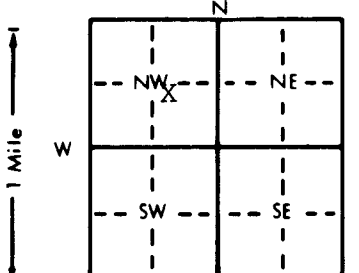


1 LOCATION OF WATER WELL: Fraction NW 1/4 SE 1/4 NW 1/4 Section Number 6 Township Number T 10 S Range Number R 10 EW

Distance and direction from nearest town or city street address of well if located within city?  
2 west, 1/4 north of Wamego

2 WATER WELL OWNER: Jess Wilson  
RR#, St. Address, Box #: 913 Ash St Board of Agriculture, Division of Water Resources  
City, State, ZIP Code: Wamego, KS 66547 Application Number:

3 LOCATE WELL'S LOCATION WITH AN "X" IN SECTION BOX:  4 DEPTH OF COMPLETED WELL: 110' ft. ELEVATION:  
Depth(s) Groundwater Encountered 1. 70-77' ft. 2. ft. 3. ft.  
WELL'S STATIC WATER LEVEL .63' ft. below land surface measured on mo/day/yr 8/21/96  
Pump test data: Well water was ft. after hours pumping gpm  
Est. Yield 9 gpm: Well water was ft. after hours pumping gpm  
Bore Hole Diameter 12" in. to ft., and in. to ft.  
WELL WATER TO BE USED AS: 5 Public water supply 8 Air conditioning 11 Injection well  
1 Domestic 3 Feedlot 6 Oil field water supply 9 Dewatering 12 Other (Specify below)  
2 Irrigation 4 Industrial 7 Lawn and garden only 10 Monitoring well  
Was a chemical/bacteriological sample submitted to Department? Yes No X; If yes, mo/day/yr sample was submitted Water Well Disinfected? Yes X No

5 TYPE OF BLANK CASING USED: 5 Wrought iron 8 Concrete tile CASING JOINTS: Glued X Clamped  
1 Steel 3 RMP (SR) 6 Asbestos-Cement 9 Other (specify below) Welded  
2 PVC 4 ABS 7 Fiberglass Threaded  
Blank casing diameter 5" in. to 0-70 ft. Dia 5" in. to 80-109 ft. Dia in. to ft.  
Casing height above land surface 24" in. weight 2.82 lbs./ft. Wall thickness or gauge No. 258  
TYPE OF SCREEN OR PERFORATION MATERIAL: 7 PVC 10 Asbestos-cement  
1 Steel 3 Stainless steel 5 Fiberglass 8 RMP (SR) 11 Other (specify)  
2 Brass 4 Galvanized steel 6 Concrete tile 9 ABS 12 None used (open hole)  
SCREEN OR PERFORATION OPENINGS ARE: 5 Gauzed wrapped 8 Saw cut 11 None (open hole)  
1 Continuous slot 3 Mill slot 6 Wire wrapped 9 Drilled holes  
2 Louvered shutter 4 Key punched 7 Torch cut 10 Other (specify)  
SCREEN-PERFORATED INTERVALS: From 70 ft. to 80 ft. From ft. to ft.  
From 109 ft. to 110 ft. From ft. to ft.  
GRAVEL PACK INTERVALS: From 24 ft. to 110 ft. From ft. to ft.  
From ft. to ft. From ft. to ft.

6 GROUT MATERIAL: 1 Neat cement 2 Cement grout 3 Bentonite 4 Other  
Grout Intervals: From 4 ft. to 24 ft. From ft. to ft. From ft. to ft.  
What is the nearest source of possible contamination: 10 Livestock pens 14 Abandoned water well  
1 Septic tank 4 Lateral lines 7 Pit privy 11 Fuel storage 15 Oil well/Gas well  
2 Sewer lines 5 Cess pool 8 Sewage lagoon 12 Fertilizer storage 16 Other (specify below)  
3 Watertight sewer lines 6 Seepage pit 9 Feedyard 13 Insecticide storage

Direction from well? NE How many feet? 150'

FROM	TO	LITHOLOGIC LOG	FROM	TO	PLUGGING INTERVALS
0	2	Top Soil			
2	12	Clay-Brown			
12	18	Fine Sand-Brown			
18	52	Clay-Brown			
52	60	FS-Cs-Brown			
60	71	Fine Sand-Brown			
71	77	FS-CS-Brown			
77	83	Clay-Brown			
83	99	Clay-Blue			
99	110	Shale-Grey			

7 CONTRACTOR'S OR LANDOWNER'S CERTIFICATION: This water well was (1) constructed, (2) reconstructed, or (3) plugged under my jurisdiction and was completed on (mo/day/year) 8/21/96 and this record is true to the best of my knowledge and belief. Kansas Water Well Contractor's License No. 182 This Water Well Record was completed on (mo/day/yr) 9-10-96 under the business name of STRADER DRILLING CO., INC. by (signature) Dale Skren

INSTRUCTIONS: Use typewriter or ball point pen. PLEASE PRESS FIRMLY and PRINT clearly. Please fill in blanks, underline or circle the correct answers. Send top three copies to Kansas Department of Health and Environment, Bureau of Water, Topeka, Kansas 66620-0001. Telephone: 913-296-5545. Send one to WATER WELL OWNER and retain one for your records.