


1 LOCATION OF WATER WELL: Fraction NW 1/4 SE 1/4 NW 1/4 Section Number 6 Township Number T ~~XX~~ 10 S Range Number R 10 **(E)N**  
 County: POTTAWATOMIE

Distance and direction from nearest town or city street address of well if located within city?  
 2 west, 1/8 north of Wamego

2 WATER WELL OWNER: Mark Wilson  
 RR#, St. Address, Box #: P.O. Box 73 Board of Agriculture, Division of Water Resources  
 City, State, ZIP Code: Wamego, KS 66547 Application Number:

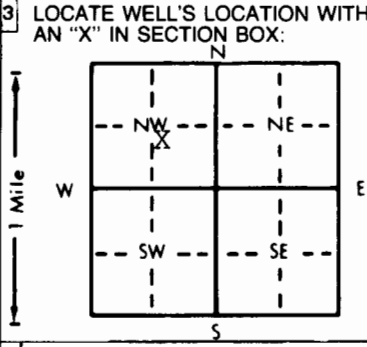

4 DEPTH OF COMPLETED WELL: 100' ft. ELEVATION: .....  
 Depth(s) Groundwater Encountered 1. .... ft. 2. .... ft. 3. .... ft.  
 WELL'S STATIC WATER LEVEL ... 65' ... ft. below land surface measured on mo/day/yr 11/25/96  
 Pump test data: Well water was ..... ft. after ..... hours pumping ..... gpm  
 Est. Yield . 4 ..... gpm: Well water was ..... ft. after ..... hours pumping ..... gpm  
 Bore Hole Diameter: 12" ..... in. to ..... ft., and ..... in. to ..... ft.  
 WELL WATER TO BE USED AS: 5 Public water supply 8 Air conditioning 11 Injection well  
 1 Domestic 3 Feedlot 6 Oil field water supply 9 Dewatering 12 Other (Specify below)  
 2 Irrigation 4 Industrial 7 Lawn and garden only 10 Monitoring well  
 Was a chemical/bacteriological sample submitted to Department? Yes ..... No ; If yes, mo/day/yr sample was submitted  
 Water Well Disinfected? Yes  No

5 TYPE OF BLANK CASING USED: 5 Wrought iron 8 Concrete tile CASING JOINTS: Glued  Clamped .....  
 1 Steel 3 RMP (SR) 6 Asbestos-Cement 9 Other (specify below) Welded .....  
 2 PVC 4 ABS 7 Fiberglass Threaded .....  
 Blank casing diameter ..... 5" in. to 0-65 ..... ft. Dia. 5" in. to 75-99 ..... ft. Dia. .... in. to ..... ft.  
 Casing height above land surface ..... 24" in. weight ..... 2.82 ..... lbs./ft. Wall thickness or gauge No. .... 258.  
 TYPE OF SCREEN OR PERFORATION MATERIAL: 7 PVC 10 Asbestos-cement  
 1 Steel 3 Stainless steel 5 Fiberglass 8 RMP (SR) 11 Other (specify) .....  
 2 Brass 4 Galvanized steel 6 Concrete tile 9 ABS 12 None used (open hole)  
 SCREEN OR PERFORATION OPENINGS ARE: 5 Gauzed wrapped 8 Saw cut 11 None (open hole)  
 1 Continuous slot 3 Mill slot 6 Wire wrapped 9 Drilled holes  
 2 Louvered shutter 4 Key punched 7 Torch cut 10 Other (specify) .....  
 SCREEN-PERFORATED INTERVALS: From ..... 65 ..... ft. to ..... 75 ..... ft., From ..... ft. to ..... ft.  
 From ..... 99 ..... ft. to ..... 100 ..... ft., From ..... ft. to ..... ft.  
 GRAVEL PACK INTERVALS: From ..... 24 ..... ft. to ..... 100 ..... ft., From ..... ft. to ..... ft.  
 From ..... ft. to ..... ft., From ..... ft. to ..... ft.

6 GROUT MATERIAL: 1 Neat cement 2 Cement grout 3 Bentonite 4 Other .....  
 Grout Intervals: From ..... 4 ..... ft. to ..... 24 ..... ft., From ..... ft. to ..... ft., From ..... ft. to ..... ft.  
 What is the nearest source of possible contamination:  
 1 Septic tank 4 Lateral lines 7 Pit privy 10 Livestock pens 14 Abandoned water well  
 2 Sewer lines 5 Cess pool 8 Sewage lagoon 11 Fuel storage 15 Oil well/Gas well  
 3 Watertight sewer lines 6 Seepage pit 9 Feedyard 12 Fertilizer storage 16 Other (specify below)  
 13 Insecticide storage  
 Direction from well? north How many feet? 200'

FROM	TO	LITHOLOGIC LOG	FROM	TO	PLUGGING INTERVALS
0	2	Top Soil			
2	33	Clay-Brown			
33	37	Clay-Grey			
37	43	Clay-Brown			
43	74	Clay-Brown			
74	96	Clay-Blue			
96	98	Limestone-Tan			
98	100	Shale-Grey			

7 CONTRACTOR'S OR LANDOWNER'S CERTIFICATION: This water well was (1) constructed, (2) reconstructed, or (3) plugged under my jurisdiction and was completed on (mo/day/year) 11/25/96 and this record is true to the best of my knowledge and belief. Kansas Water Well Contractor's License No. 182 This Water Well Record was completed on (mo/day/yr) 1-2-97 under the business name of STRADER DRILLING CO., INC. by (signature) Dale Skron

OFFICE USE ONLY  
T  
R  
EW  
SEC.