

MW-8


1 LOCATION OF WATER WELL: County: <u>Pottawatomie</u>	Fraction <u>SW 1/4 SW 1/4 SE 1/4</u>	Section Number <u>4</u>	Township Number <u>T 10 S</u>	Range Number <u>R 10 EW</u>
--	---	----------------------------	----------------------------------	--------------------------------

Distance and direction from nearest town or city street address of well if located within city?
300' southeast of 530 Lincoln, Wamego, Ks. (in Senior Citizen Center west parking lot)

2 WATER WELL OWNER: Home Oil Company
RR#, St. Address, Box #: Box 196
City, State, ZIP Code: Wamego, Ks. 66547

Board of Agriculture, Division of Water Resources
Application Number:

3 LOCATE WELL'S LOCATION WITH AN "X" IN SECTION BOX:

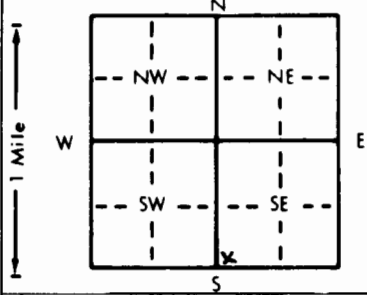

4 DEPTH OF COMPLETED WELL: 40 ft. ELEVATION:

Depth(s) Groundwater Encountered 1. 34 ft. 2. ft. 3. ft.

WELL'S STATIC WATER LEVEL ft. below land surface measured on mo/day/yr

Pump test data: Well water was ft. after hours pumping gpm

Est. Yield gpm: Well water was ft. after hours pumping gpm

Bore Hole Diameter: 6 in. to 40 ft., and in. to ft.

WELL WATER TO BE USED AS:
 1 Domestic 3 Feedlot 6 Oil field water supply 9 Dewatering 12 Other (Specify below)
 2 Irrigation 4 Industrial 7 Lawn and garden only 10 Monitoring well

Was a chemical/bacteriological sample submitted to Department? Yes No 7; If yes, mo/day/yr sample was submitted

Water Well Disinfected? Yes No Y

5 TYPE OF BLANK CASING USED:

1 Steel	3 RMP (SR)	6 Asbestos-Cement	9 Other (specify below)
<u>2</u> PVC	4 ABS	<u>7</u> Fiberglass	

Blank casing diameter: 2 in. to 35 ft., Dia. in. to ft., Dia. in. to ft.

Casing height above land surface in., weight lbs./ft. Wall thickness or gauge No.

CASING JOINTS: Glued Clamped Welded Threaded

TYPE OF SCREEN OR PERFORATION MATERIAL:

1 Steel	3 Stainless steel	5 Fiberglass	8 RMP (SR)	10 Asbestos-cement
2 Brass	4 Galvanized steel	6 Concrete tile	9 ABS	11 Other (specify)
				12 None used (open hole)

SCREEN OR PERFORATION OPENINGS ARE:

1 Continuous slot	<u>3</u> Mill slot	5 Gauzed wrapped	8 Saw cut	11 None (open hole)
2 Louvered shutter	4 Key punched	6 Wire wrapped	9 Drilled holes	
		7 Torch cut	10 Other (specify)	

SCREEN-PERFORATED INTERVALS: From 40 ft. to 25 ft., From ft. to ft.

GRAVEL PACK INTERVALS: From 40 ft. to 23 ft., From ft. to ft.

6 GROUT MATERIAL: 1 Neat cement 2 Cement grout 3 Bentonite 4 Other

Grout Intervals: From 23 ft. to 2 ft., From ft. to ft., From ft. to ft.

What is the nearest source of possible contamination:

1 Septic tank	4 Lateral lines	7 Pit privy	<u>10</u> Fuel storage	14 Abandoned water well
2 Sewer lines	5 Cess pool	8 Sewage lagoon	12 Fertilizer storage	15 Oil well/Gas well
3 Watertight sewer lines	6 Seepage pit	9 Feedyard	13 Insecticide storage	16 Other (specify below)

Direction from well? How many feet?

FROM	TO	LITHOLOGIC LOG	FROM	TO	PLUGGING INTERVALS
<u>0</u>	<u>10</u>	<u>BRN BRN Clay</u>			
<u>10</u>	<u>40</u>	<u>BRN SILT</u>			

7 CONTRACTOR'S OR LANDOWNER'S CERTIFICATION: This water well was (1) constructed, (2) reconstructed, or (3) plugged under my jurisdiction and was completed on (mo/day/year) 9-30-96 and this record is true to the best of my knowledge and belief. Kansas Water Well Contractor's License No. 568 This Water Well Record was completed on (mo/day/yr) 10-19-96 under the business name of Max's by (signature) David Hyngh

INSTRUCTIONS: Use typewriter or ball point pen. PLEASE PRESS FIRMLY and PRINT clearly. Please fill in blanks, underline or circle the correct answers. Send top three copies to Kansas Department of Health and Environment, Bureau of Water, Topeka, Kansas 66620-0001. Telephone: 913-296-5545. Send one to WATER WELL OWNER and retain one for your records.