


MW-4

1 LOCATION OF WATER WELL:	Fraction	Section Number	Township Number	Range Number
County: <u>Pottawatomie</u>	<u>SW 1/4 SW 1/4 SE 1/4</u>	<u>4</u>	T <u>10</u> S	R <u>10</u> <u>EW</u>

Distance and direction from nearest town or city street address of well if located within city?
20' southeast of 530 Lincoln, Wamego, Ks. (in alleyway)

2 WATER WELL OWNER: Home Oil Company
 RR#, St. Address, Box #: Box 196
 City, State, ZIP Code: Wamego, Ks. 66547
 Board of Agriculture, Division of Water Resources
 Application Number:

3 LOCATE WELL'S LOCATION WITH AN "X" IN SECTION BOX:

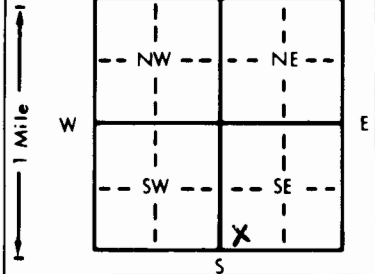

4 DEPTH OF COMPLETED WELL: 40 ft. ELEVATION:
 Depth(s) Groundwater Encountered 1. 33 ft. 2. ft. 3. ft.

WELL'S STATIC WATER LEVEL: ft. below land surface measured on mo/day/yr
 Pump test data: Well water was ft. after hours pumping gpm
 Est. Yield gpm: Well water was ft. after hours pumping gpm
 Bore Hole Diameter: 6 in. to 40 ft. and in. to ft.

WELL WATER TO BE USED AS:
 1 Domestic 2 Irrigation 3 Feedlot 4 Industrial 5 Public water supply 6 Oil field water supply 7 Lawn and garden only 8 Air conditioning 9 Dewatering 10 Monitoring well 11 Injection well 12 Other (Specify below)
 Was a chemical/bacteriological sample submitted to Department? Yes No
 If yes, mo/day/yr sample was submitted: Yes No

5 TYPE OF BLANK CASING USED:
 1 Steel 2 PVC 3 RMP (SR) 4 ABS 5 Wrought iron 6 Asbestos-Cement 7 Fiberglass 8 Concrete tile 9 Other (specify below) CASING JOINTS: Glued Clamped Welded Threaded
 Blank casing diameter: 2 in. to 25 ft., Dia. in. to ft., Dia. in. to ft.
 Casing height above land surface: in., weight lbs./ft. Wall thickness or gauge No.

TYPE OF SCREEN OR PERFORATION MATERIAL:
 1 Steel 2 Brass 3 Stainless steel 4 Galvanized steel 5 Fiberglass 6 Concrete tile 7 RMP (SR) 8 ABS 9 Other (specify) 10 Asbestos-cement 11 Other (specify) 12 None used (open hole)

SCREEN OR PERFORATION OPENINGS ARE:
 1 Continuous slot 2 Louvered shutter 3 Mill slot 4 Key punched 5 Gauzed wrapped 6 Wire wrapped 7 Torch cut 8 Saw cut 9 Drilled holes 10 Other (specify) 11 None (open hole)

SCREEN-PERFORATED INTERVALS: From 40 ft. to 25 ft., From ft. to ft.
 GRAVEL PACK INTERVALS: From 40 ft. to 23 ft., From ft. to ft.

6 GROUT MATERIAL: 1 Neat cement 2 Cement grout 3 Bentonite 4 Other
 Grout Intervals: From 23 ft. to 80 ft., From ft. to ft., From ft. to ft.
 What is the nearest source of possible contamination:
 1 Septic tank 2 Sewer lines 3 Watertight sewer lines 4 Lateral lines 5 Cess pool 6 Seepage pit 7 Pit privy 8 Sewage lagoon 9 Feedyard 10 Livestock pens 11 Fuel storage 12 Fertilizer storage 13 Insecticide storage 14 Abandoned water well 15 Oil well/Gas well 16 Other (specify below)

FROM	TO	LITHOLOGIC LOG	FROM	TO	PLUGGING INTERVALS
0	10	BRN Clay			
10	40	BRN Silty Clay			

7 CONTRACTOR'S OR LANDOWNER'S CERTIFICATION: This water well was (1) constructed, (2) reconstructed, or (3) plugged under my jurisdiction and was completed on (mo/day/year) 9-30-96 and this record is true to the best of my knowledge and belief. Kansas Water Well Contractor's License No. 568. This Water Well Record was completed on (mo/day/yr) 9-30-96 under the business name of Max's by (signature) David Hays