


1 LOCATION OF WATER WELL: Fraction Section Number Township Number Range Number
County: Wabaunsee NE 1/4 SE 1/4 SW 1/4 30 T 10 S R 10 (E/W)
Distance and direction from nearest town or city street address of well if located within city?
In the Village of Wabaunsee 39°08.853 N 096°20.728 W

2 WATER WELL OWNER: Danail Hunt
RR#, St. Address, Box #: Rt 1 Box 41
City, State, ZIP Code: Wabaunsee, KS 66547
Board of Agriculture, Division of Water Resources
Application Number:

3 LOCATE WELL'S LOCATION WITH AN "X" IN SECTION BOX:
4 DEPTH OF COMPLETED WELL: 75 ft. ELEVATION:
WELL'S STATIC WATER LEVEL: 52 ft. below land surface measured on mo/day/yr 1/15/02
Pump test data: Well water was 2.5 gpm; Est. Yield 2.5 gpm; Bore Hole Diameter 10 in. to 7.6 in.
WELL WATER TO BE USED AS: 5 Public water supply, 8 Air conditioning, 11 Injection well, 1 Domestic, 3 Feedlot, 6 Oil field water supply, 9 Dewatering, 12 Other (Specify below)
Was a chemical/bacteriological sample submitted to Department? Yes \* No; Water Well Disinfected? Yes \* No

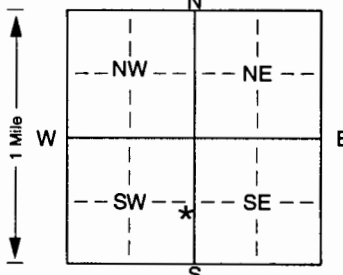

5 TYPE OF BLANK CASING USED: 1 Steel, 2 PVC, 3 RMP (SR), 4 ABS, 5 Wrought iron, 6 Asbestos-Cement, 7 Fiberglass, 8 Concrete tile, 9 Other (specify below), CASING JOINTS: Glued, \* Clamped, Welded, Threaded.
Blank casing diameter 5 in. to 5.5 ft., Dia. Casing height above land surface 18 in., weight 200 lbs./ft. Wall thickness or gauge No. 2.65.
TYPE OF SCREEN OR PERFORATION MATERIAL: 1 Steel, 2 Brass, 3 Stainless steel, 4 Galvanized steel, 5 Fiberglass, 6 Concrete tile, 7 PVC, 8 RMP (SR), 9 ABS, 10 Asbestos-cement, 11 Other (specify), 12 None used (open hole)
SCREEN OR PERFORATION OPENINGS ARE: 1 Continuous slot, 2 Louvered shutter, 3 Mill slot, 4 Key punched, 5 Gauzed wrapped, 6 Wire wrapped, 7 Torch cut, 8 Saw cut, 9 Drilled holes, 10 Other (specify), 11 None (open hole)
SCREEN-PERFORATED INTERVALS: From 55 ft. to 75 ft.
GRAVEL PACK INTERVALS: From 25 ft. to 75 ft.

6 GROUT MATERIAL: 1 Neat cement, 2 Cement grout, 3 Bentonite, 4 Other
Grout Intervals: From 5 ft. to 25 ft.
What is the nearest source of possible contamination: 1 Septic tank, 2 Sewer lines, 3 Watertight sewer lines, 4 Lateral lines, 5 Cess pool, 6 Seepage pit, 7 Pit privy, 8 Sewage lagoon, 9 Feedyard, 10 Livestock pens, 11 Fuel storage, 12 Fertilizer storage, 13 Insecticide storage, 14 Abandoned water well, 15 Oil well/Gas well, 16 Other (specify below)
Direction from well? NE How many feet? 60

Table with columns: FROM, TO, LITHOLOGIC LOG, FROM, TO, PLUGGING INTERVALS.
Rows: 0-4 Topsoil, 4-34 Brown Clay, 34-71 Sand (Med.-Course/Yellow), 71-76 Gray Shale

7 CONTRACTOR'S OR LANDOWNER'S CERTIFICATION: This water well was (1) constructed, (2) reconstructed, or (3) plugged under my jurisdiction and was completed on (mo/day/year) 1/15/02 and this record is true to the best of my knowledge and belief. Kansas Water Well Contractor's Licence No. 518. This Water Well Record was completed on (mo/day/yr) 1/20/02 under the business name of Blue Valley Drilling by (signature) Danail Hunt